

BENCHMARKS  
COLLIN COUNTY GPS MONUMENT NO.107.  
STATE PLANE COORDINATES: N=7,162,670.5090 E=2,530,072.8220  
ELEVATION=673.03'  
TEMPORARY BENCHMARK.  
TOP OF NORTH END OF CONCRETE HEADWALL ON WEST SIDE OF F.M. 543 (WESTON ROAD)  
APPROXIMATELY 1.067" SOUTH OF THE NORTHEAST CORNER OF THE SUBJECT PROPERTY.  
APPROXIMATE STATE PLANE COORDINATES: N=7,166,417.1± E=2,529,937.4±  
ELEVATION=684.71'

SITE DEVELOPMENT PLANS FOR  
LOT 90, BLOCK A  
VAN BUREN ESTATES

NORTHWEST CORNER OF  
F.M.543 (WESTON ROAD) AND C.R.170  
WESTON, TX 75097

SHEET INDEX

- COVER SHEET  
PLAT
- C1.0 PAVING PLAN ~ EISENHOWER COURT
- C2.0 EROSION CONTROL PLAN
- C3.0 OFFSITE DRAINAGE AREA MAP
- C3.1 PRE-DEV DRAINAGE AREA MAP
- C3.2 DRAINAGE AREA MAP (1 OF 2)
- C3.3 DRAINAGE AREA MAP (2 OF 2)
- C3.4 DRAINAGE CALCULATIONS
- C4.0 STORM SEWER~CHANNEL
- C4.1 STORM SEWER~CULV.A1, LN.1, SPILLWAY
- C5.0 DETAILS
- C6.0 GENERAL NOTES
- C7.0 CITY GENERAL NOTES
- C8.0 CITY DETAILS
- C8.1 CITY DETAILS
- C8.2 CITY DETAILS
- C8.3 CITY DETAILS
- C9.0 TxDOT DETAILS
- C9.1 TxDOT DETAILS
- C9.2 TxDOT DETAILS
- C9.3 TxDOT DETAILS

ZONED - RED-1

OWNER:  
VAN BUREN ESTATES, LLC


A TEXAS LIMITED LIABILITY COMPANY  
CONTACT: JON ANDERSON  
1221 N. JEFFERSON AVENUE  
MT. PLEASANT, TEXAS 75455  
(903) 563-2122

ENGINEER:  
JM CIVIL ENGINEERING

CONTACT: JOHN MEASELS, PE (ENGINEER)  
5900 S. LAKE FOREST DRIVE, SUITE 380  
McKINNEY, TEXAS 75070  
JMEASELS@JMCIVILENG.COM  
(214) 491-1830  
FIRM NO. F-19504

SURVEYOR:  
TEXAS HERITAGE SURVEYING, LLC

CONTACT: GARY JOHNSON (SURVEYOR)  
10610 METRIC DR., SUITE 124  
DALLAS, TEXAS 75243  
(214) 340-9700

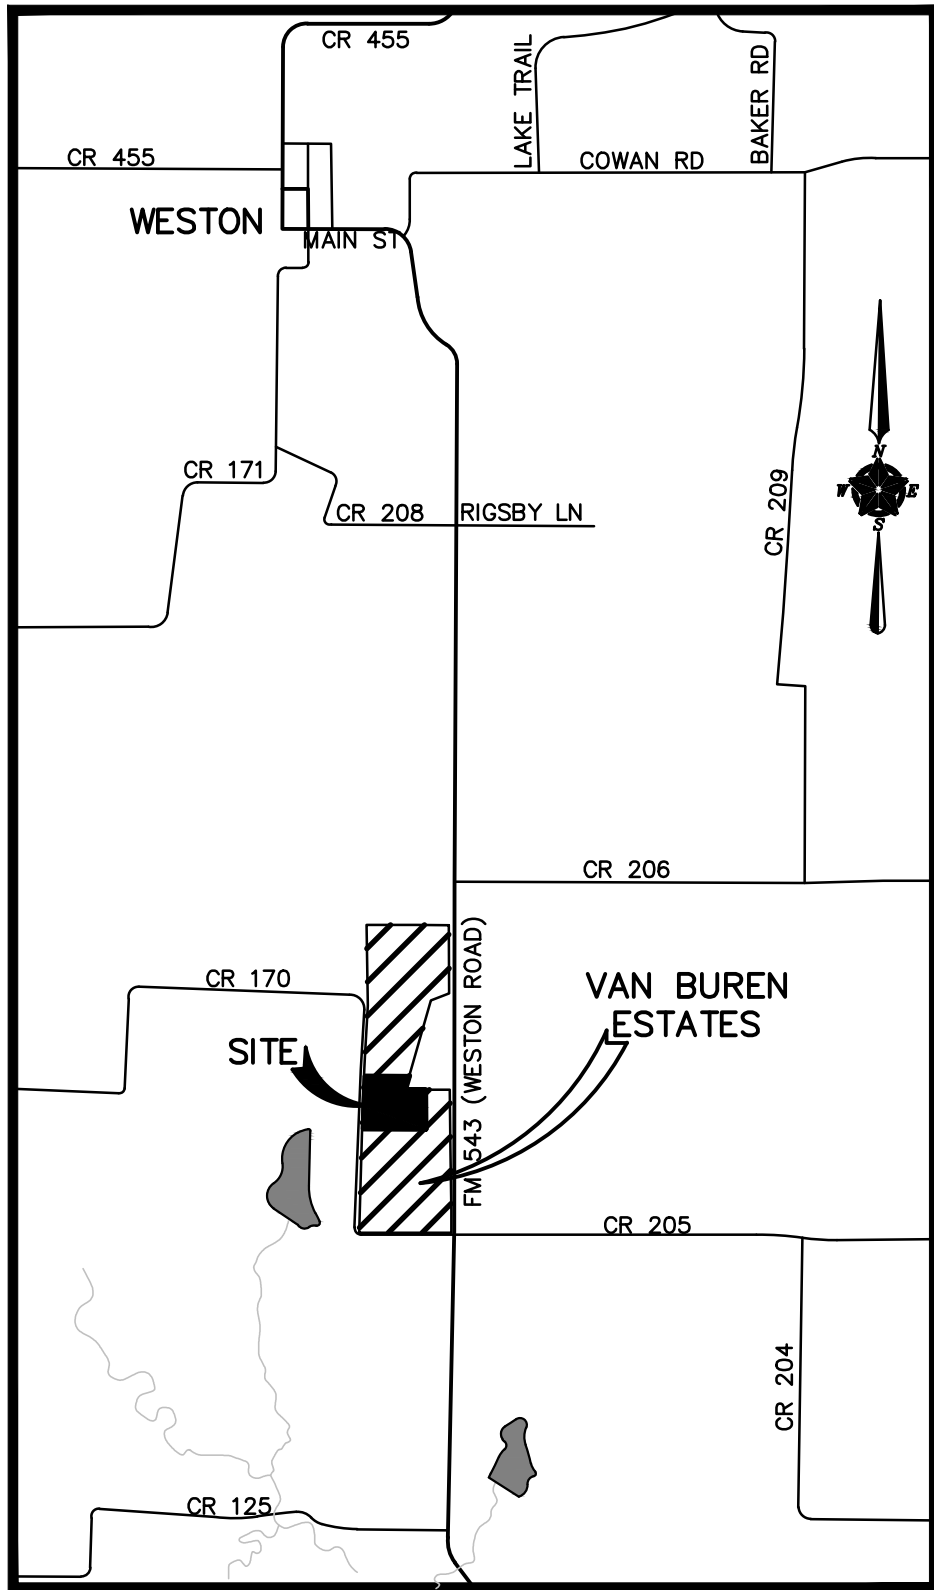


LOCATION MAP  
NOT TO SCALE

FLOOD NOTE  
A PORTION OF THE SUBJECT PROPERTY IS SHOWN ON THE NATIONAL FLOOD INSURANCE PROGRAM FLOOD INSURANCE RATE MAP FOR COLLIN COUNTY, TEXAS, MAP NO. 48085C0135 J, COMMUNITY--PANEL NO. 481324 0135 J, MAP REVISED: JUNE 2, 2009. THE PORTION OF THE SUBJECT PROPERTY ON SAID MAP IS SHOWN TO BE LOCATED IN ZONE "X". RELEVANT ZONES ARE DEFINED ON SAID MAP AS FOLLOWS: ZONE "X" -- OTHER AREAS: AREAS DETERMINED TO BE OUTSIDE THE 0.2% ANNUAL CHANCE FLOODPLAIN.  
THE REMAINDER OF THE SUBJECT PROPERTY IS SHOWN ON THE NATIONAL FLOOD INSURANCE PROGRAM FLOOD INSURANCE RATE MAP FOR COLLIN COUNTY, TEXAS, MAP NO. 48085C0145 J, COMMUNITY--PANEL NO. 481324 0145 J, MAP REVISED: JUNE 2, 2009. A PORTION OF THE SUBJECT PROPERTY ON SAID MAP IS SHOWN TO BE LOCATED IN ZONE "A" AND ZONE "X". RELEVANT ZONES ARE DEFINED ON SAID MAP AS FOLLOWS:  
ZONE "A" -- SPECIAL FLOOD HAZARD AREAS (SFHAs) SUBJECT TO INUNDATION BY THE 1% ANNUAL CHANCE FLOOD: NO BASE FLOOD ELEVATIONS DETERMINED.  
ZONE "X" -- OTHER AREAS: AREAS DETERMINED TO BE OUTSIDE THE 0.2% ANNUAL CHANCE FLOODPLAIN.



5900 S. Lake Forest Dr., Suite 380  
McKinney, TX 75070  
Ph. 214-491-1830  
John Measels, PE  
CIVIL ENGINEER  
FIRM NO. 19504

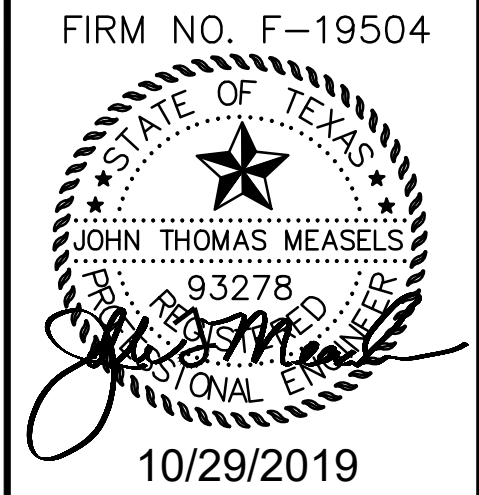

LOT 90, BLOCK A, VAN BUREN ESTATES  
NORTHWEST CORNER OF F.M.543 (WESTON ROAD)  
AND C.R.170 WESTON, TX 75097

PROJECT NO.	DATE	DESCRIPTION	NAME
JM-HYB001.0	10/29/19	AS BUILT	TWA
DRAWN BY:			
CHECKED BY:			
ISSUE DATE:	10/29/19		

COVER SHEET



AS BUILT  
10/29/2019

THIS RECORD DRAWING IS A COMPILATION OF SEALED ENGINEERING DRAWINGS FOR THIS PROJECT MODIFIED BY INFORMATION FURNISHED BY THE CONTRACTOR, BASED ON THE CONTRACTORS' INFORMATION AND GENERAL INSPECTION BY THE CITY.



OWNER'S DEDICATION

NOW, THEREFORE, KNOW ALL MEN BY THESE PRESENTS:

THAT, Van Buren Estates, LLC, a Texas limited liability company, acting herein by and through it's authorized officers, do hereby certify and adopt this plat designating the hereinabove described property as **VAN BUREN ESTATES, PHASE II**, an Addition to the City of Weston, and does hereby dedicate, in fee simple, to the public use forever, the streets and alleys shown thereon. The streets and alleys are dedicated for street purposes. The easements and public use areas, as shown, are dedicated for the public use forever, for the purposes indicated on this plat. No buildings, fences, trees, shrubs, or other improvements or growths shall be constructed or placed upon, over, or across the easements as shown, except that landscape improvements may be placed in landscape easements, if approved by the City of Weston. In addition, utility easements may also be used for the mutual use and accommodation of all public utilities desiring to use or using the same unless the easement limits the use to particular utilities, said use by public utilities being subordinate to the public's and City of Weston's use thereof. The City of Weston and public utility entities shall have the right to remove and keep removed all or parts of any buildings, fences, trees shrubs, or other improvements or growths which may in any way endanger or interfere with the construction, maintenance or efficiency of their respective systems in said easements. The City of Weston and public utility entities shall at all times have the full right of ingress and egress to or from their respective easements for the purpose of construction, reconstructing, inspecting, patrolling, maintaining, reading meters, and adding to or removing all or parts of their respective systems with the necessity at any of procuring permission from anyone.

That the undersigned does hereby covenant and agree that he (they) shall construct upon the fire lane easements, as dedicated and shown hereon, a hard surface and that he (they) shall maintain the same in a state of good repair at all times and keep the same free and clear of any structures, fences, trees, shrubs, or other improvements or obstruction, including but not limited to the parking of motor vehicles, trailers, boats, or other impediments to the access of fire apparatus. The maintenance of paving on the fire lane easements is the responsibility of the owner, and the owner shall post and maintain appropriate signs in conspicuous places along such fire lanes, stating "Fire Lane, No Parking." The police or his duly authorized representative is hereby authorized to cause such fire lanes and utility easements to be maintained free and unobstructed at all times for Fire Department and emergency use.

The undersigned does covenant and agree that the access easement may be utilized by any person or the general public for ingress and egress to other real property, and for the purpose of General Public vehicular and -pedestrian use and access, and for Fire Department and emergency use, in, along, upon, and across said premises, with the right and privilege at all times of the City of Weston, its agents, employees, workmen, and representatives having ingress, egress, and regress in, along, upon, and across said premises.

This plat approved subject to all platting ordinances, rules, regulations and resolutions of the City of Weston, Texas.

WITNESS MY HAND THIS \_\_\_\_ DAY OF \_\_\_\_\_, 2018.

Van Buren Estates, LLC, a Texas limited liability company

Owner/Agent

STATE OF TEXAS

COUNTY OF COLLIN

BEFORE ME, the undersigned authority, a Notary Public in and for the State of Texas, on this day personally appeared \_\_\_\_\_, known to me to be the person whose name is subscribed to the foregoing instrument and acknowledged to me that he/she executed the same for the purposes and considerations therein expressed and in the capacity therein stated and as the act and deed therein stated.

GIVEN UNDER MY HAND AND SEAL OF OFFICE, this \_\_\_\_ day of \_\_\_\_\_, 2018.

Notary Signature


Notary Signature

LEGEND			
○ IRON ROD FOUND	— OHP —	— OVERHEAD POWER LINE	
⊗ IRON ROD SET	— E —	— UNDERGROUND ELECTRIC LINE	
○ IRON PIPE FOUND	— — —	— EASEMENT LINE	
⊠ "X" FOUND / SET	— B.L. —	— BUILDING LINE	
● POWER POLE	— W — W —	— EXISTING WATER LINE	
	— W — W —	— PROPOSED WATER LINE	
D.R.C.C.T. DEED RECORDS, COLLIN COUNTY, TEXAS			
O.P.R.C.C.T. OFFICIAL PUBLIC RECORDS, COLLIN COUNTY, TEXAS			
PROPERTY LINE			

PARCEL CURVE TABLE				
CURVE #	LENGTH	RADIUS	DELTA	CHORD
C1	233.92'	150.00'	89°21'07"	S45° 02' 36"E 210.93'
C2	325.42'	60.00'	310°45'05"	N89° 37' 58"E 50.00'
C3	155.95'	100.00'	89°21'07"	N45° 02' 36"W 140.62'
C10	194.94'	125.00'	89°21'08"	S45° 02' 35"E 175.77'



SCS EASEMENT CURVE TABLE				
CURVE #	LENGTH	RADIUS	DELTA	CHORD
C4	69.32'	67.60'	58°44'55"	N67° 38' 26"E 66.32'
C5	221.23'	553.95'	22°52'56"	N49° 42' 26"E 219.76'
C6	54.64'	100.00'	31°18'16"	S64° 58' 25"E 53.96'
C7	55.26'	150.00'	21°06'35"	N61° 25' 00"W 54.95'
C8	45.51'	189.67'	13°44'53"	S41° 26' 02"W 45.40'
C9	159.17'	146.47'	62°15'49"	S65° 41' 30"W 151.46'
C11	35.22'	287.07'	07°01'50"	N57° 37' 59"E 35.20'

VICINITY MAP - NOT TO SCALE

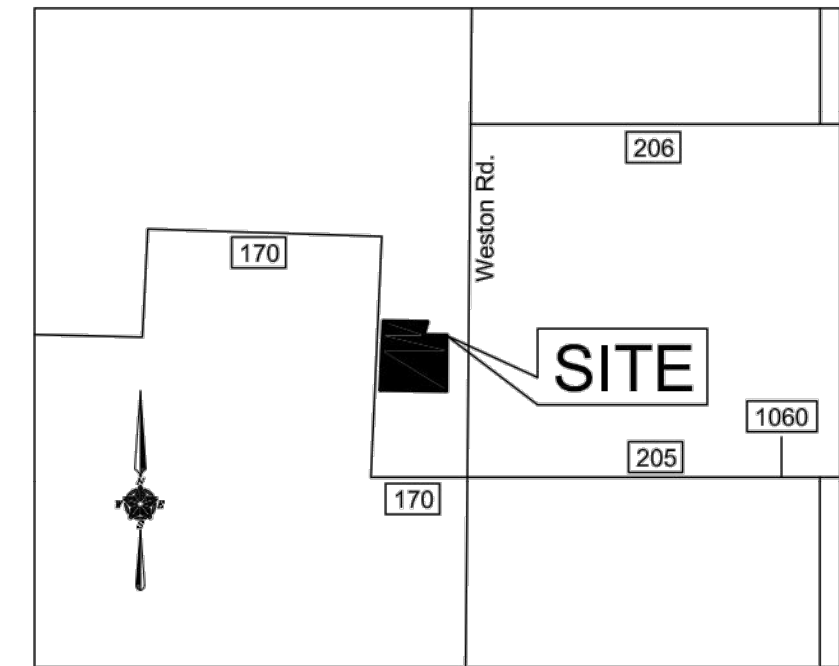

SCS EASEMENT LINE TABLE		
LINE #	LENGTH	DIRECTION
L1	104.73'	N1°37'52"E
L2	174.19'	S82°59'07"E
L3	21.88'	N36°37'55"E
L4	67.79'	N54°22'35"E
L5	72.51'	N48°57'39"E
L6	117.97'	N37°55'55"E
L7	3.65'	S55°36'47"E
L8	118.76'	S30°29'19"W
L9	66.21'	S19°08'43"W
L10	114.61'	S52°19'09"W
L11	86.00'	S48°18'28"W
L12	94.10'	S34°33'36"W
L13	162.27'	N83°10'35"W

DRAINAGE EASEMENT LINE TABLE		
LINE #	LENGTH	DIRECTION
L14	17.37'	N16°07'02"E
L15	25.84'	N00°16'51"E
L16	19.89'	N89°37'58"E
L17	47.00'	S0°22'02"E
L18	15.00'	S89°37'58"W

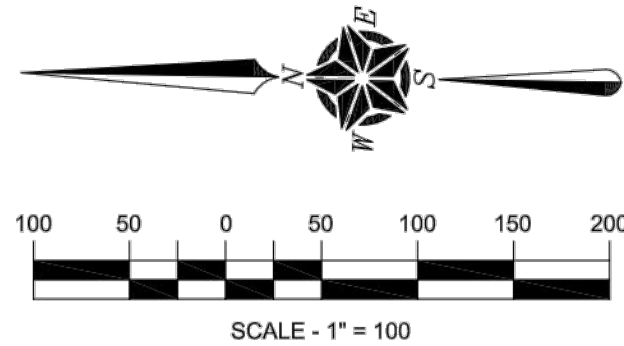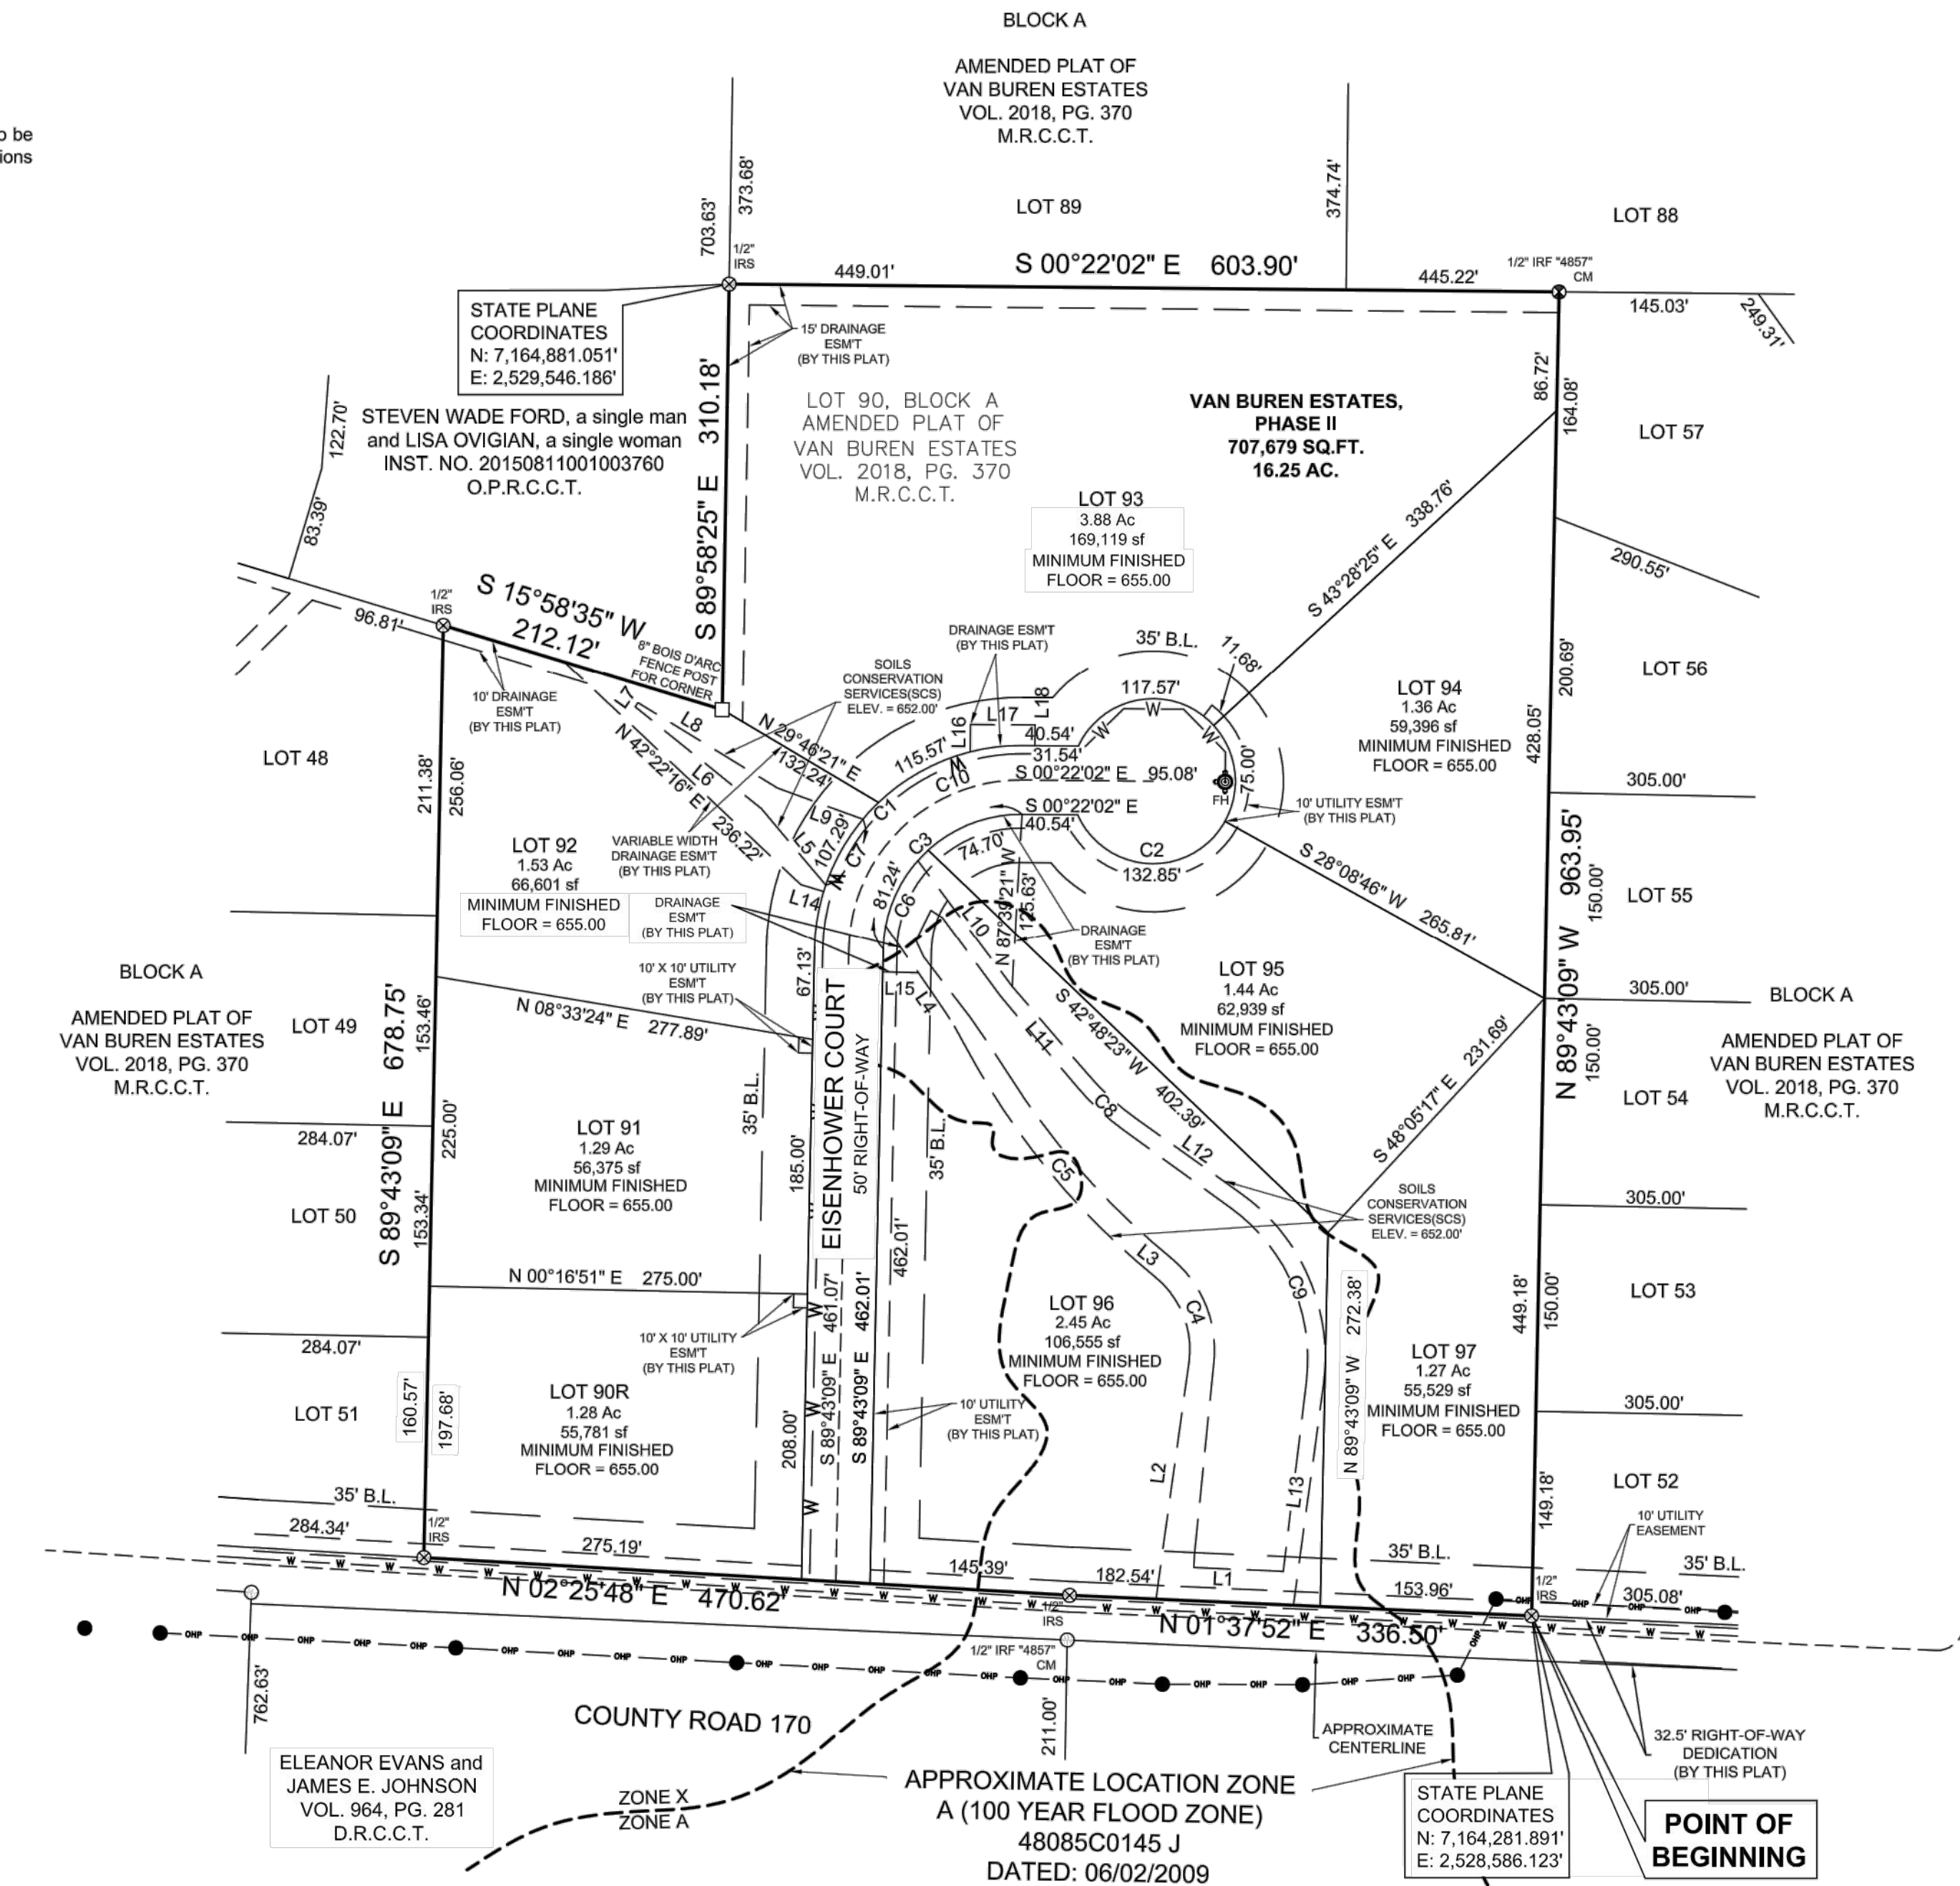

GENERAL NOTES:

- 1) Bearings are based upon the Texas State Plane Coordinate System, North Central Zone, North American Datum of 1983, (2011). Distances are shown as surface values.
- 2) Selling a portion of this addition by metes and bounds is a violation of City Subdivision Ordinance and State Platting Statutes and is subject to fines and withholding of utilities and building permits.
- 3) This property is located in "Non-shaded Zone X" as scaled from the F.E.M.A. Flood Insurance Rate Map dated April 18, 2011 and is located in Community Number 480194 as shown on Map number 4812C0390G. The location of the Flood Zone is approximate, no vertical datum was collected at the time of the survey. For the exact Flood Zone designation, please contact 1-(877) FEMA MAP.
- 4) The bearings shown on this survey were derived from Western Data Systems RTK Network and are referenced to the Texas Coordinate System of 1983, North Central Zone (4202) and are based on the American Datum of 1983, 2011 Adjustment.
- 5) The existing creeks or drainage channels traversing along or across the addition will remain as open channels and will be maintained by individual owners of the lot or lots that are traversed by or adjacent to the drainage course along or across said lots.
- 6) Collin County will not be responsible for the maintenance and operation of said drainage ways or for the control of erosion in said drainage ways.
- 7) Collin County will not be responsible for any damage, personal injury or loss of life or property occasioned by flooding or flooding conditions.
- 8) Collin County permits are required for building construction, on-site sewage facilities and driveway culverts.
- 9) All lots must utilize alternative type On-Site Sewage Facilities. Presence of fractured rock throughout the subdivision may further limit the type of alternative type On-Site Sewage Facilities to Aerobic Treatment with Surface Application on individual lots and may interfere with tank placement.
- 10) All lots must maintain state-mandated setback of all On-Site Sewage Facility components from any/all easements and drainage areas, water distribution lines, sharp breaks and/or creeks/streams/ponds, etc. (Per State regulations.)
- 11) Tree removal and/or grading for OSSF may be required on individual lots.
- 12) Individual site evaluations and OSSF design plans (meeting all State and County requirements) must be submitted to and approved by Collin County for each lot prior to construction or any OSSF system.
- 13) There are no water wells noted in this subdivision and no water wells are allowed without prior approval from Collin County Development Services.
- 14) TBM=684.70 (Temporary Benchmark) located on a concrete headwall, approximately 3,859 feet from the North right-of-way line of County Road 170 on the West right-of-way line of F.M. 543.

OWNER'S CERTIFICATE

STATE OF TEXAS  
COUNTY OF COLLIN

WHEREAS, Van Buren Estates, LLC, a Texas limited liability company is the owner of a tract of land situated in the Leonidas Wilson Survey, Abstract No. 982 in Collin County, Texas, and being a portion out of the Amended Plat of Van Buren Estates, an Addition to the City of Weston, Collin County, Texas, according to the Map thereof recorded in Volume 2018, Page 370, Map Records, Collin County, Texas, said tract being conveyed to Van Buren Estates, LLC, a Texas limited liability company, by Special Warranty Deed recorded in Instrument No. 20170615000779230, Official Public Records, Collin County, Texas, and being more particularly described by metes and bounds as follows:

Beginning at a 1/2 inch iron rod set with yellow plastic cap stamped "TXHS" in the East line of County Road 170 at the Northwest corner of Lot 52, Block A of said Amended Plat of Van Buren Estates and being the Southwest corner of the herein described tract;

Thence North 01 degrees 37 minutes 52 seconds East, along said East line of County Road 170, a distance of 336.50 feet to a 1/2 inch iron rod set with yellow plastic cap stamped "TXHS", for an angle point in said East line;

Thence North 02 degrees 25 minutes 48 seconds East, continuing along said East line of County Road 170, a distance of 470.62 feet to a 1/2 inch iron rod set with yellow plastic cap stamped "TXHS" at the Southwest corner of Lot 51, Block A of said Amended Plat of Van Buren Estates and being the Northwest corner of the herein described tract;

Thence South 89 degrees 43 minutes 09 seconds East, departing said East line of County Road 170, a distance of 678.75 feet to a 1/2 inch iron rod set with yellow plastic cap stamped "TXHS" at the Southeast corner of Lot 48, Block A of said Amended Plat of Van Buren Estates and lying in the Northwest line of a tract of land conveyed to Steven Wade Ford, a single man and Lisa Ovigian, a single woman, by Deed recorded in Instrument No. 20150811001003760, Official Public Records, Collin County, Texas;

Thence South 15 degrees 58 minutes 35 seconds West, along said Northwest line of Ford/Ovigian tract, a distance of 212.12 feet to an 8 inch Bois D'Arc fence post at the Southwest corner of said Ford/Ovigian tract, and being an interior corner of the herein described tract;

Thence South 89 degrees 58 minutes 25 seconds East, along the South line of said Ford/Ovigian tract, a distance of 310.18 feet to a 1/2 inch iron rod set with yellow plastic cap stamped "TXHS" at the Northwest corner of Lot 89, Block A of said Amended Plat of Van Buren Estates, for the most Easterly Northeast corner of the herein described tract;

Thence South 00 degrees 22 minutes 02 seconds East, along the West line of said Lot 89, Block A, common with the East line of the herein described tract, a distance of 603.90 feet to a 1/2 inch iron rod found with cap stamped "4857" at the Northeast corner of Lot 57, Block A of said Amended Plat of Van Buren Estates, for the Southeast corner of the herein described tract;

Thence North 89 degrees 43 minutes 09 seconds West, along the North line of said Lot 57, Block A, common with the South line of the herein described tract, a distance of 963.95 feet to the POINT OF BEGINNING and containing 707,679 square feet or 16.25 acres of land.

SURVEYORS CERTIFICATE

STATE OF TEXAS  
COUNTY OF DALLAS

THAT I, Raul D. Reyes, do hereby certify that I prepared this plat and the field notes made a part thereof from an actual and accurate survey on the land and that the corner monuments shown thereon were found and/or properly placed under my personal supervision in accordance with the Subdivision regulations of the City of Weston, Texas.

Preliminary, this document shall not be recorded for any purposes and shall not be used or viewed or relied upon as a final survey document. (07/27/2018)

Raul D. Reyes  
Registered Professional Land Surveyor No. 5390

STATE OF TEXAS  
COUNTY OF DALLAS

BEFORE ME, the undersigned a Notary Public in and for The State of Texas, on this day personally appeared Raul D. Reyes, known to me to be the person whose name is subscribed to the foregoing instrument, and acknowledge to the me that he executed the same purposes and considerations therein expressed and in the capacity therein stated.

GIVEN UNDER MY HAND AND SEAL OF OFFICE, this the \_\_\_\_ day of \_\_\_\_\_, 2018.

Notary Public

Notary Public

HEALTH DEPARTMENT CERTIFICATION:

I hereby certify that the on-site sewage facilities described on this plat conform to the applicable OSSF laws of the State of Texas, that site evaluations have been submitted representing the site conditions in the area in which on-site sewage facilities are planned to be used.

Registered Sanitarian or Designated Representative  
Collin County Development Services

Notary Public

CERTIFICATE OF APPROVAL

Approved this the \_\_\_\_ day of \_\_\_\_\_, 2018 by the Planning & Zoning Commission of the City of Weston, Texas.

Planning and Zoning Commission Chairperson

Notary Public

STATE OF TEXAS  
COUNTY OF COLLIN

BEFORE ME, the undersigned authority, a Notary Public in and for the State of Texas, on this day personally appeared \_\_\_\_\_, known to me to be the person whose name is subscribed to the foregoing instrument and acknowledged to me that he/she executed the same for the purposes and considerations therein expressed and in the capacity therein stated and as the act and deed therein stated.

GIVEN UNDER MY HAND AND SEAL OF OFFICE, this \_\_\_\_ day of \_\_\_\_\_, 2018.

Notary Signature

Notary Signature

Proposed zoning is:  
"Residential Estates District 1" (RED 1)

PRELIMINARY PLAT  
**VAN BUREN ESTATES, PHASE II**  
LOTS 90A-97, BLOCK A  
707,679 SQ. FT. / 16.25 AC.  
REPLAT OF THE AMENDED PLAT OF  
VAN BUREN ESTATES  
VOLUME 2018, PAGE 370,  
MAP RECORDS, COLLIN COUNTY, TEXAS  
LEONIDAS WILSON SURVEY, ABSTRACT NO. 982  
CITY OF WESTON, COLLIN COUNTY, TEXAS

DATE: 07/25/18 / JOB # 1801062-1 / SCALE - 1" = 100' / CN

SURVEYOR  
**TEXAS HERITAGE**  
SURVEYING, LLC


10610 Metric Drive, Suite 124, Dallas, TX 75243  
Office 214-340-9700 Fax 214-340-9710  
txheritage.com  
Firm #10169300



OWNER  
VAN BUREN ESTATES, LLC  
a Texas limited liability company  
1221 N. Jefferson Avenue  
Mt. Pleasant, Texas 75455  
attn: Amy Burnside  
Ph: 214-616-1820  
amy@reedross.com





BENCHMARKS  
COLLIN COUNTY GPS MONUMENT NO.107.  
STATE PLANE COORDINATES: N=7,162,670.5090 E=2,530,072.8220  
ELEVATION=673.03'  
TEMPORARY BENCHMARK.  
TOP OF NORTH END OF CONCRETE HEADWALL ON WEST SIDE OF F.M. 543 (WESTON ROAD)  
APPROXIMATELY 1,067' SOUTH OF THE NORTH-EAST CORNER OF THE SUBJECT PROPERTY.  
APPROXIMATE STATE PLANE COORDINATES: N=7,166,417.1± E=2,529,937.4±  
ELEVATION=684.7'

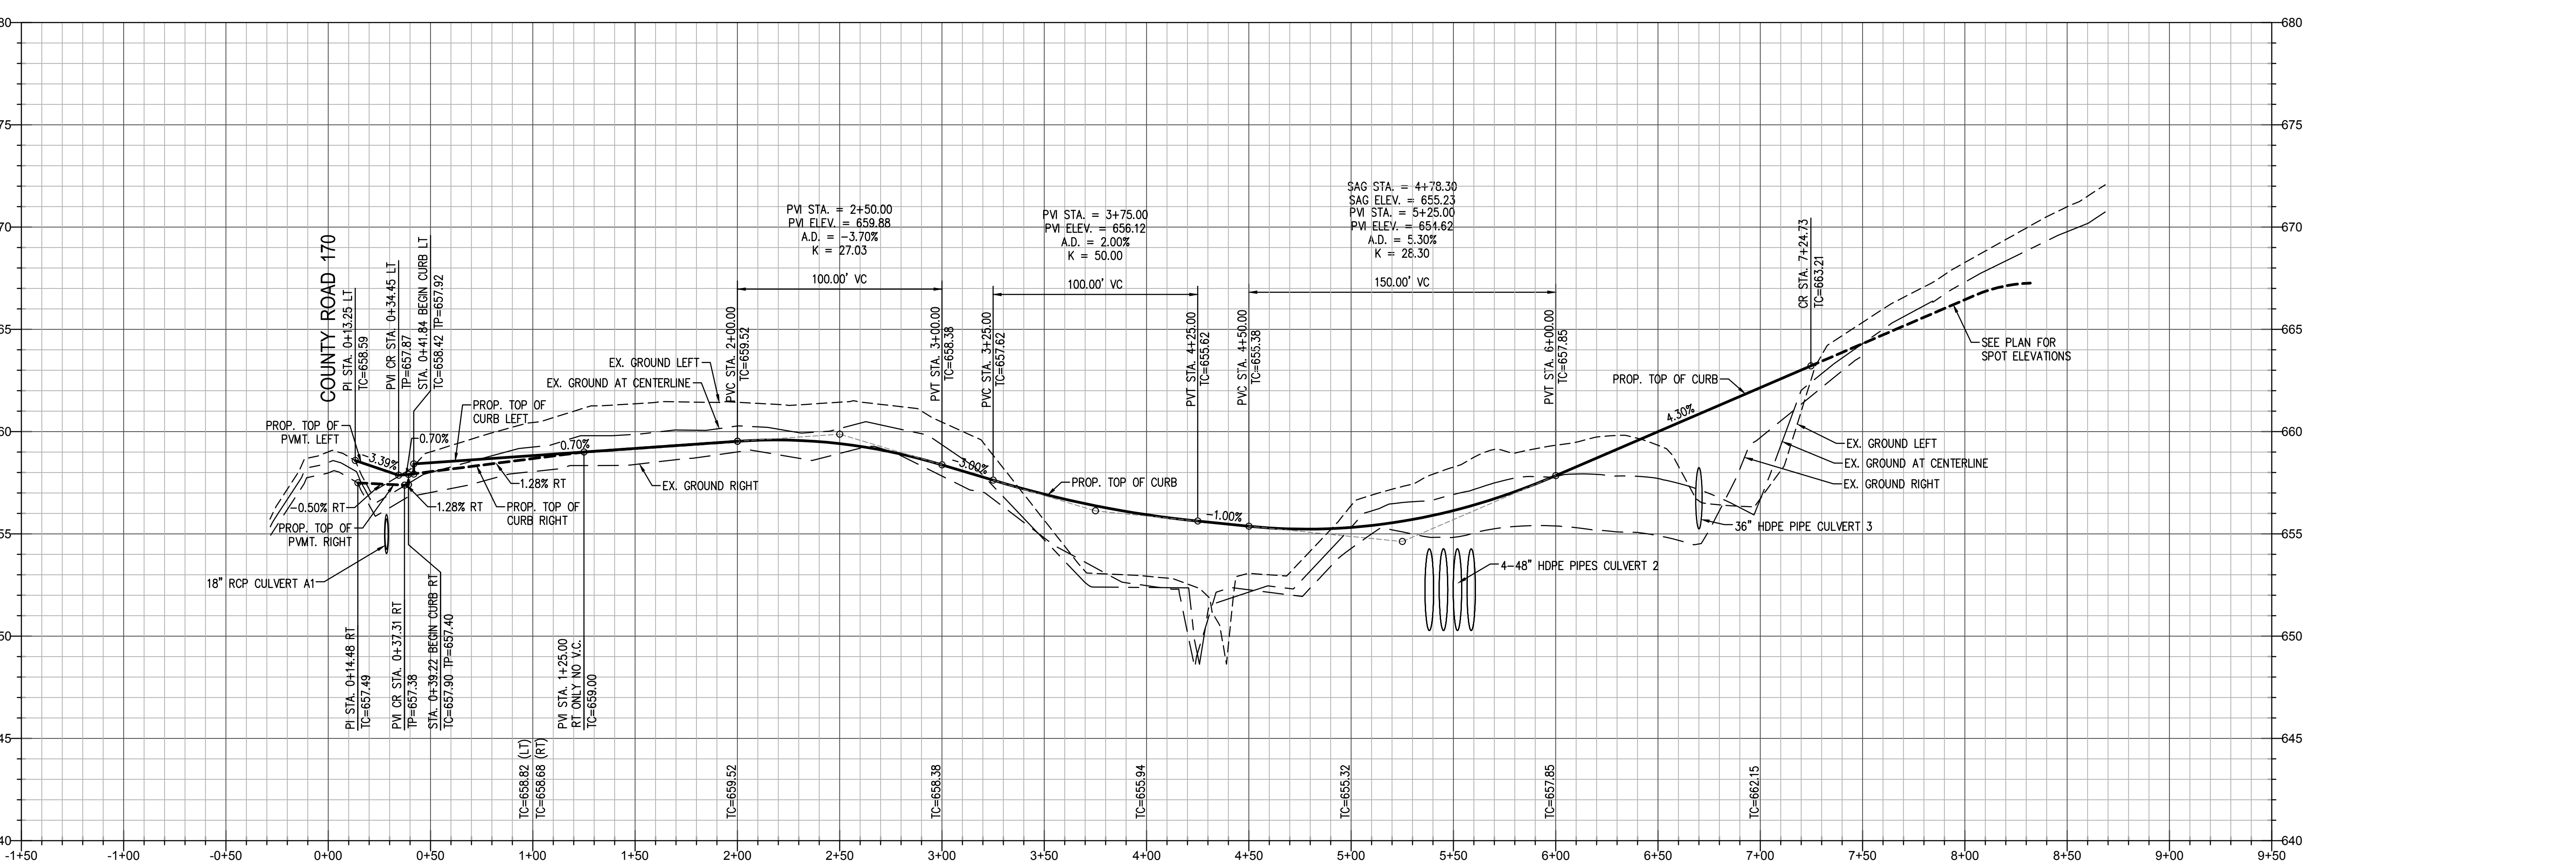





CAUTION NOTICE TO CONTRACTOR  
THE CONTRACTOR IS SPECIFICALLY CAUTIONED THAT THE LOCATION AND/OR ELEVATION OF EXISTING UTILITIES AS SHOWN ON THESE PLANS ARE BASED ON RECORDS OF THE VARIOUS UTILITY COMPANIES AND, WHERE POSSIBLE, MEASUREMENTS TAKEN IN THE FIELD. THE INFORMATION IS NOT TO BE RELIED ON AS BEING EXACT OR COMPLETE. THE CONTRACTOR MUST CALL THE APPROPRIATE UTILITY COMPANY AT LEAST 14 DAYS BEFORE ANY EXCAVATION TO REQUEST EXACT FIELD LOCATION OF UTILITIES. IT SHALL BE THE RESPONSIBILITY OF THE CONTRACTOR TO RELOCATE ALL EXISTING UTILITIES WHICH CONFLICT WITH THE PROPOSED IMPROVEMENTS SHOWN ON THE PLANS.

BENCHMARKS  
COLLIN COUNTY GPS MONUMENT NO.107,  
STATE PLANE COORDINATES: N=7,162,670.5090 E=2,530,072.8220  
ELEVATION=673.03'  
TEMPORARY BENCHMARK,  
TOP OF NORTH END OF CONCRETE HEADWALL ON WEST SIDE OF F.M. 543 (WESTON ROAD)  
APPROXIMATELY 1,067' SOUTH OF THE NORTHEAST CORNER OF THE SUBJECT PROPERTY.  
APPROXIMATE STATE PLANE COORDINATES: N=7,166,417.1± E=2,529,937.4±  
ELEVATION=684.71'

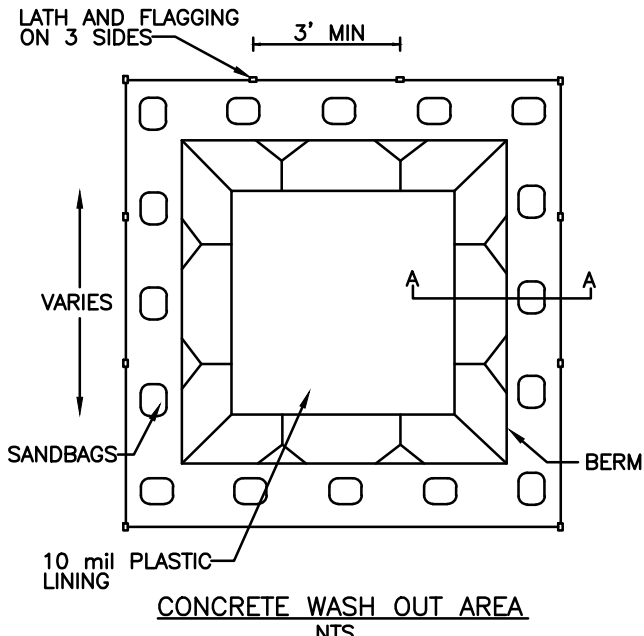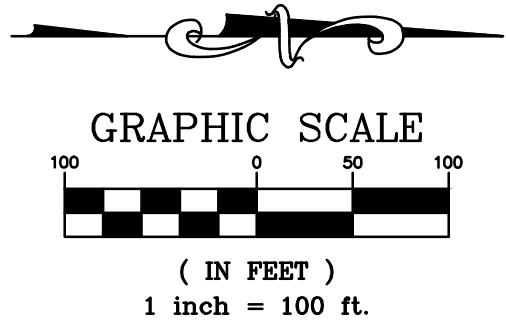

- NOTES:
1. ACTUAL SIZE DETERMINED IN THE FIELD.
  2. THE CONCRETE WASHOUT SIGN SHALL BE INSTALLED WITHIN 30 FEET OF THE TEMPORARY CONCRETE WASHOUT FACILITY.

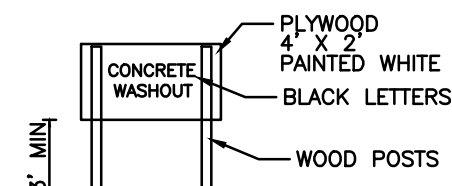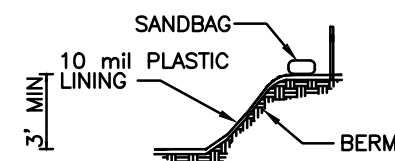

#### EROSION CONTROL KEY NOTES

1. TEMPORARY CONSTRUCTION ENTRANCE
2. TEMPORARY SILT FENCE
3. TEMPORARY INLET PROTECTION
4. MIN. 10'X10' CONCRETE WASH AREA (SHALL COMPLY WITH TCEQ GENERAL PERMIT PART V)

#### SEQUENCE OF CONSTRUCTION ACTIVITIES:

- A. CONSTRUCT TEMPORARY CONSTRUCTION ENTRANCE AND SILT FENCE ACCORDING TO THE APPROXIMATE LOCATION SHOWN ON THE EROSION CONTROL PLAN.
- B. CONSTRUCT TEMPORARY INLET TREATMENT AROUND OPEN STORM DRAIN INLETS ACCORDING TO THE EROSION CONTROL PLAN.
- C. KEEP ALL STORM WATER POLLUTION PREVENTION MEASURES IN PLACE.
- D. BEGIN CLEARING AND GRADING OF SITE.
- E. INSTALL WATER, SANITARY SEWER AND STORM DRAIN AS SPECIFIED ON PLAN SHEETS.
- F. PAVE STREETS AND SIDEWALKS AS SPECIFIED ON PLAN SHEETS.
- G. RE-VEGETATE LOTS, PARKWAYS AND ALL DISTURBED AREAS.
- H. REMOVE ALL TEMPORARY EROSION CONTROL DEVICES.

#### MAINTENANCE:

- A. CONTRACTOR TO KEEP ALL STORM WATER POLLUTION PREVENTION MEASURES IN PLACE DURING CONSTRUCTION.
- B. CONTRACTOR SHALL MAINTAIN ALONG WITH THE SIGNED EFFECTIVE COPY OF SWP3 DRAWINGS AN UPDATED LIST IDENTIFYING ALL POTENTIAL SOURCES OF POLLUTION INCLUDING PORTA-POTTYS, FUEL TANKS, STAGING AREAS, WASTE CONTAINERS, CHEMICAL STORAGE AREAS, CONCRETE CURE, PAINTS SOLVENTS, ETC., AND A DESCRIPTION OF THE LOCATION.
- C. CONTRACTOR TO REMOVE ALL STORM WATER POLLUTION PREVENTION MEASURES AFTER CONSTRUCTION IS COMPLETE AND INSPECTED FOR APPROVAL. LONG TERM MAINTENANCE TO BE PROVIDED BY OWNER.

#### NOTES:

1. CONTRACTOR SHALL POLICE SITE REGULARLY AND AND KEEP SITE FREE OF TRASH AND CONSTRUCTION DEBRIS.
2. ALL EROSION CONTROL DEVICES SHALL BE CONSTRUCTED AND MAINTAINED IN COMPLIANCE WITH CITY STANDARD EROSION CONTROL DETAILS
3. TOTAL DISTURBED AREA=2.75 ACRES.
4. REFER TO LANDSCAPE PLAN FOR FINAL GROUND STABILIZATION (SHEET L1 ATTACHED).




AS BUILT  
10/29/2019

THIS RECORD DRAWING IS A COMPILATION OF SEALED ENGINEERING DRAWINGS FOR THIS PROJECT MODIFIED BY INFORMATION FURNISHED BY THE CONTRACTOR, BASED ON THE CONTRACTORS' INFORMATION AND GENERAL INSPECTION BY THE CITY.

PROJECT NO.	DATE	DESCRIPTION	AS BUILT
JM-RT-001.0	10/29/19	AS BUILT	
DRAWN BY:	TWA	CHECKED BY:	AS
ISSUE DATE:	10/29/19		



J:\PRESIDENTIAL LAND\WESTON, TX - 170 & 543\CURRENT DRAWINGS LOT 90\DRAWING LOT 90.DWG 10/20/2019 10:16 AM TIM ANDRIES

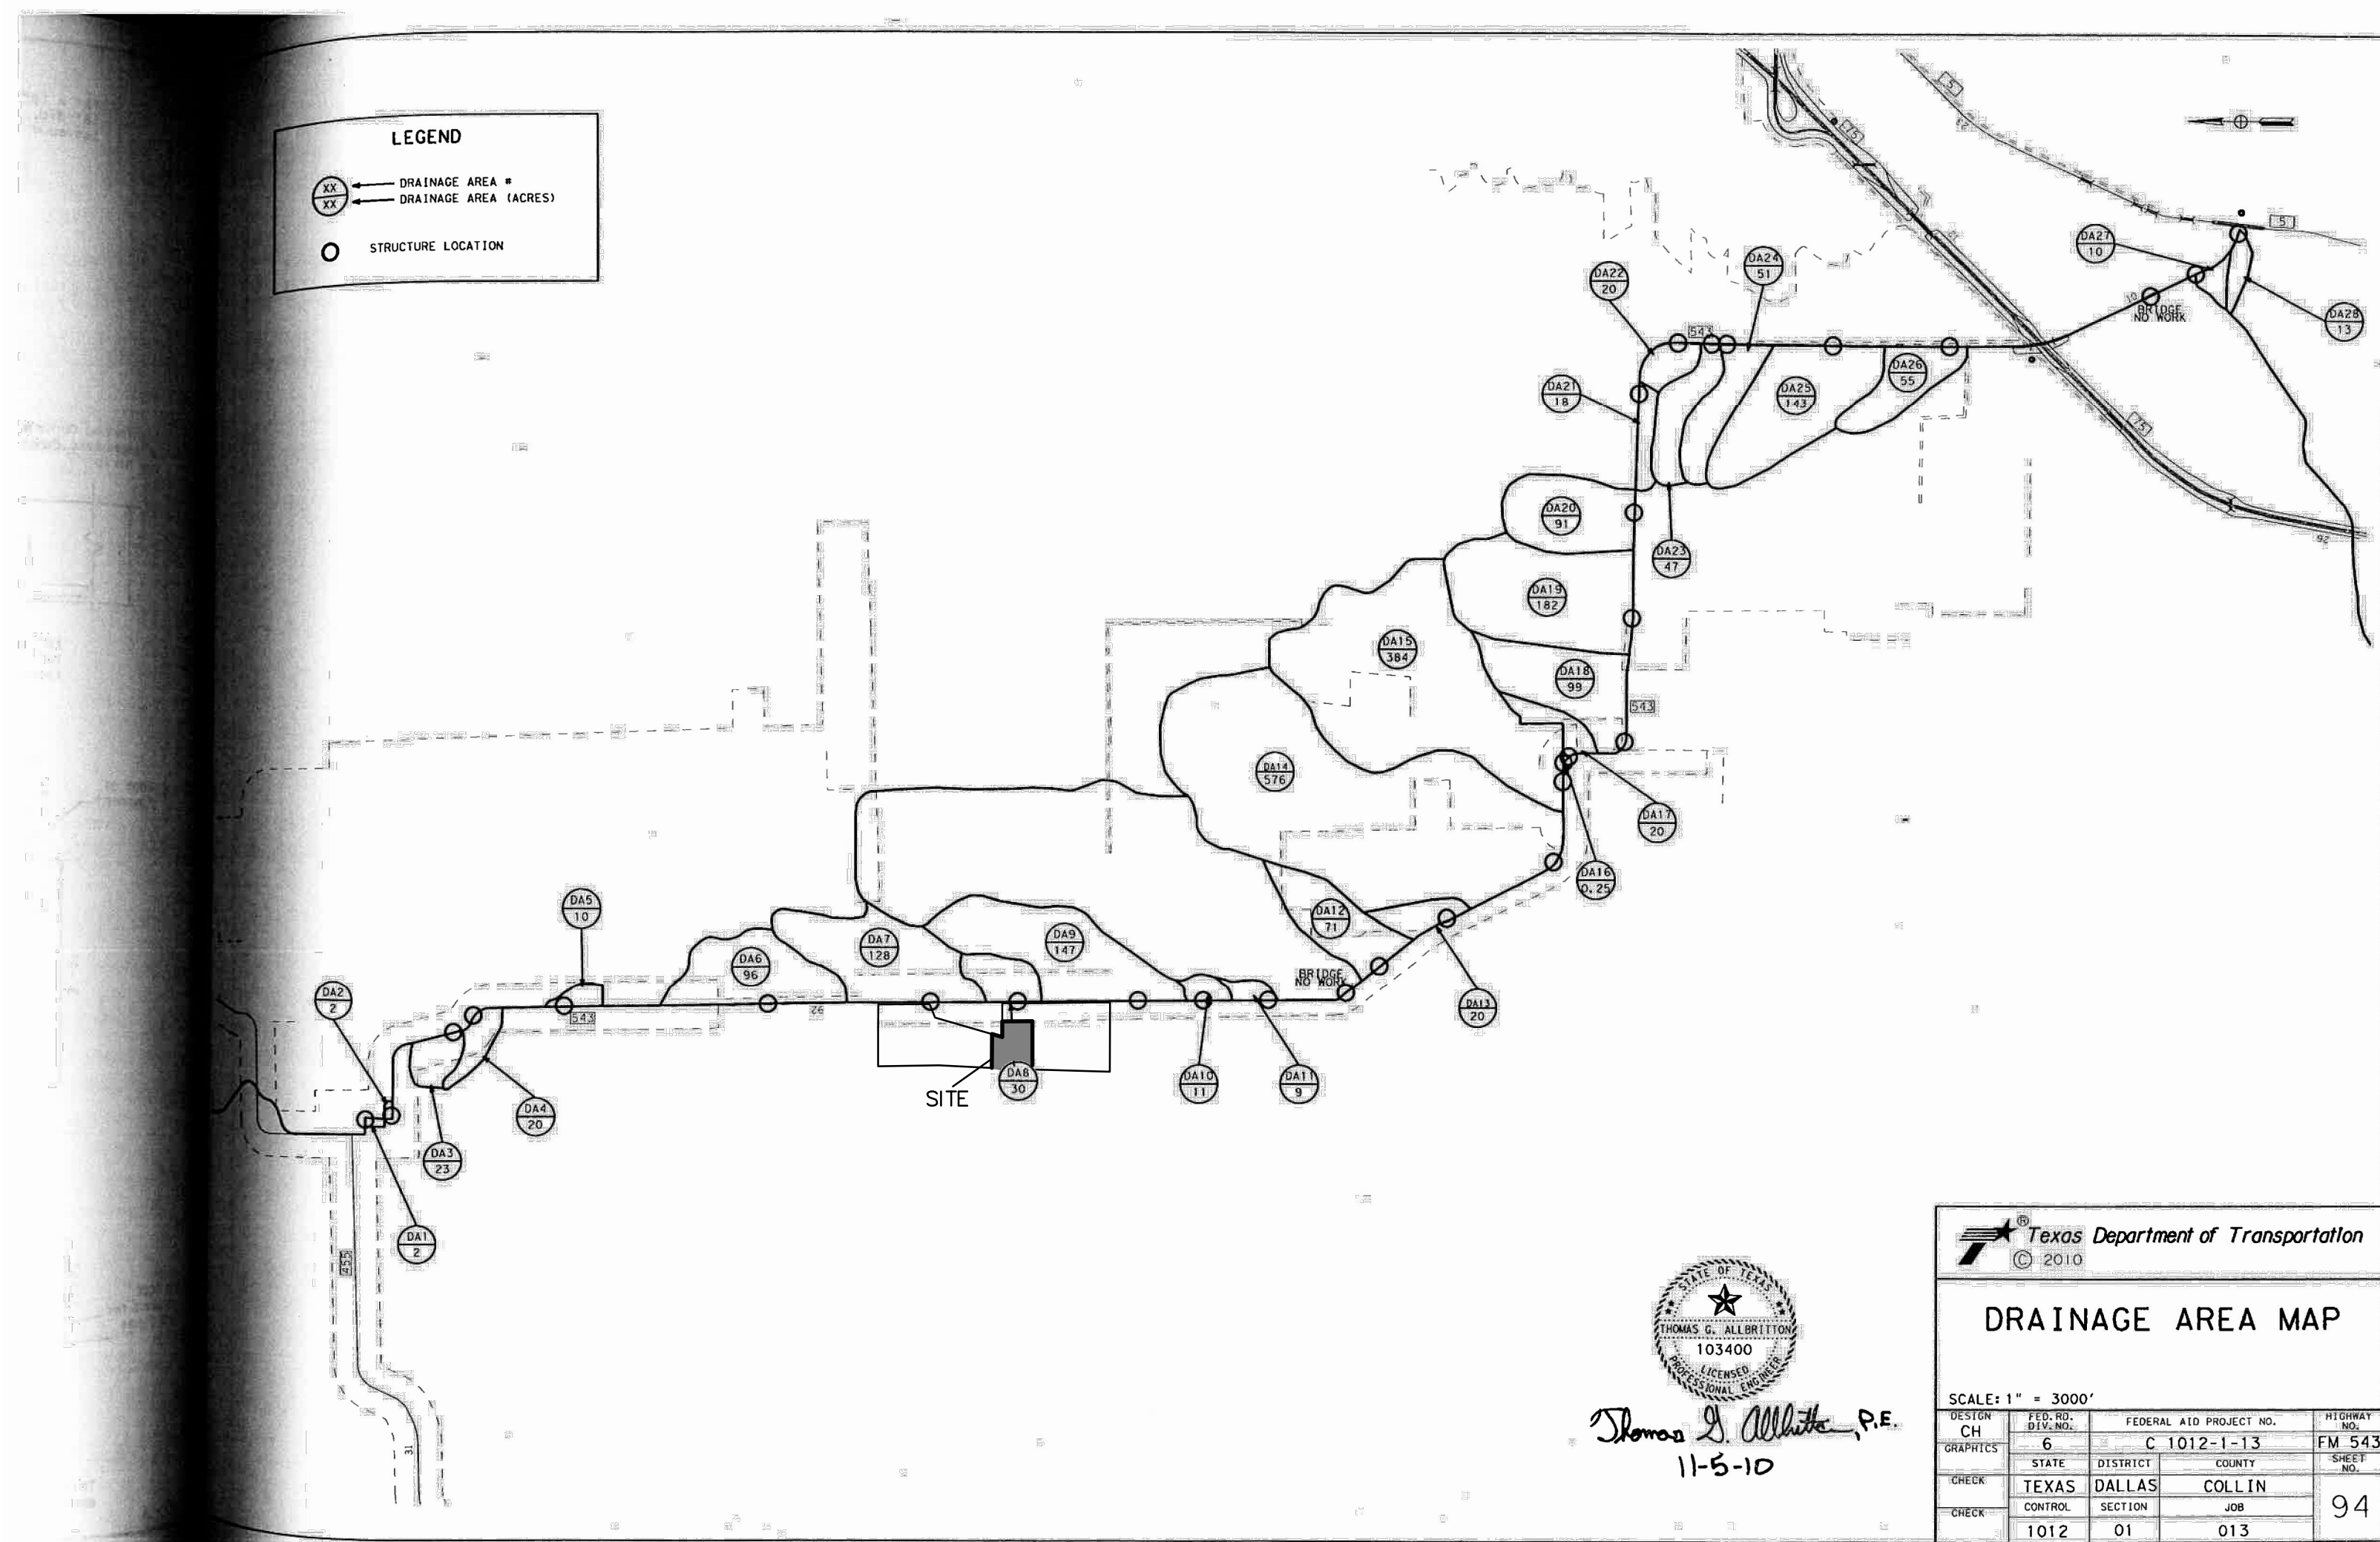

Discharge Summary - Rational Method  
CSJ: 1012-01-013

STR. #	AREA acres	tc min.	2 YR		5 YR		10 YR		25 YR		50 YR		100 YR	
			C	Q in / hr cfs	C	Q in / hr cfs	C	Q in / hr cfs	*C	Q in / hr cfs	*C	Q in / hr cfs	*C	Q in / hr cfs
2	2	21	0.50	3.7	0.50	4.7	0.50	5.6	0.55	6.5	0.60	7.3	0.63	8.0
3	23	39	0.30	2.6	0.30	3.3	0.30	3.9	0.33	4.5	0.36	5.1	0.38	5.6
4	20	42	0.30	2.4	0.30	3.1	0.30	3.7	0.33	4.3	0.36	4.8	0.38	5.3
5	10	40	0.30	2.5	0.30	3.2	0.30	3.8	0.33	4.4	0.36	5.0	0.38	5.5
6	96	40	0.30	2.5	0.30	3.2	0.30	3.8	0.33	4.5	0.36	5.0	0.38	5.5
7	128	53	0.30	2.1	0.30	2.7	0.30	3.2	0.33	3.7	0.36	4.1	0.38	4.6
8	30	36	0.30	2.7	0.30	3.4	0.30	4.1	0.33	4.7	0.36	5.3	0.38	5.8
9	147	59	0.30	1.9	0.30	2.5	0.30	3.0	0.33	3.4	0.36	3.9	0.38	4.3
10	11	27	0.30	3.2	0.30	4.1	0.30	4.9	0.33	5.7	0.36	6.4	0.38	7.0
11	9	41	0.30	2.5	0.30	3.2	0.30	3.8	0.33	4.4	0.36	4.9	0.38	5.4
12	71	50	0.30	2.2	0.30	2.8	0.30	3.3	0.33	3.8	0.36	4.3	0.38	4.7
13	22	55	0.30	2.0	0.30	2.6	0.30	3.1	0.33	3.6	0.36	4.0	0.38	4.5
14	0.25	10	0.50	3.5	0.40	6.8	0.30	8.1	0.33	9.4	0.36	10.5	0.38	11.6
15	20	51	0.30	2.2	0.30	2.8	0.30	3.3	0.33	3.8	0.36	4.3	0.38	4.7
16	99	58	0.30	2.0	0.30	2.5	0.30	3.0	0.33	3.5	0.36	3.9	0.38	4.3
17	182	67	0.30	1.8	0.30	2.3	0.30	2.7	0.33	3.2	0.36	3.6	0.38	3.9
18	91	52	0.30	2.1	0.30	2.7	0.30	3.2	0.33	3.7	0.36	4.2	0.38	4.6
19	18	47	0.30	2.3	0.30	2.9	0.30	3.5	0.33	4.0	0.36	4.5	0.38	5.0
20	20	29	0.30	3.1	0.30	3.9	0.30	4.7	0.33	5.4	0.36	6.1	0.38	6.7
21	47	49	0.30	2.2	0.30	2.8	0.30	3.4	0.33	3.9	0.36	4.4	0.38	4.8
22	51	48	0.30	2.2	0.30	2.8	0.30	3.4	0.33	3.9	0.36	4.4	0.38	4.8
23	143	58	0.30	2.0	0.30	2.5	0.30	3.0	0.33	3.5	0.36	3.9	0.38	4.3
24	55	61	0.30	1.9	0.30	2.4	0.30	2.9	0.33	3.4	0.36	3.8	0.38	4.2
25	10	23	0.50	3.6	0.40	6.8	0.30	8.1	0.33	9.4	0.36	10.5	0.38	11.6
26	13	60	0.30	1.9	0.30	2.5	0.30	2.9	0.33	3.4	0.36	3.8	0.38	4.2

\*C = Adjusted Runoff Coefficient (Hydraulic Design Manual, page 5-31)

Discharge Summary - NRCS Method

CSJ: 1012-01-013

STR. #	AREA sq mi	tc min.	Curve #	2 YR		5 YR		10 YR		25 YR		50 YR		100 YR	
				Rainfall (P) in	Q cfs	Rainfall (P) in	Q cfs	Rainfall (P) in	Q cfs	Rainfall (P) in	Q cfs	Rainfall (P) in	Q cfs		
14	0.90	83	80	2.04	415	3.24	664	4.14	847	5.25	1068	6.19	1255	7.14	1442
15	0.60	75	80	2.04	295	3.24	471	4.14	601	5.25	760	6.19	892	7.14	1025

Thomas S. Albright, P.E.  
11-4-10

Texas Department of Transportation  
© 2010

DISCHARGE SUMMARY

SECTION	CH	FED. AID PROJECT NO.	HIGHWAY NO.
GRAPHICS	6	C 1012-1-13	FM 543
CHECK	STATE	DISTRICT	COUNTY
CHECK	TEXAS	DALLAS	COLLIN
CHECK	CONTROL	SECTION	JOB
CHECK	1012	01	013

95

AS BUILT  
10/29/2019

THIS RECORD DRAWING IS A COMPILATION OF SEALED ENGINEERING DRAWINGS FOR THIS PROJECT MODIFIED BY INFORMATION FURNISHED BY THE CONTRACTOR, BASED ON THE CONTRACTORS' INFORMATION AND GENERAL INSPECTION BY THE CITY.



CAUTION NOTICE TO CONTRACTOR  
THE CONTRACTOR IS SPECIFICALLY CAUTIONED THAT THE LOCATION AND/OR ELEVATION OF EXISTING UTILITIES AS SHOWN ON THESE PLANS ARE BASED ON RECORDS OF THE VARIOUS UTILITY COMPANIES AND, WHERE POSSIBLE, MEASUREMENTS TAKEN IN THE FIELD. THE INFORMATION IS NOT TO BE RELIED ON AS BEING EXACT OR COMPLETE. THE CONTRACTOR MUST CALL THE APPROPRIATE UTILITY COMPANY AT LEAST 14 DAYS BEFORE ANY EXCAVATION TO REQUEST EXACT FIELD LOCATION OF UTILITIES. IT SHALL BE THE RESPONSIBILITY OF THE CONTRACTOR TO RELOCATE ALL EXISTING UTILITIES WHICH CONFLICT WITH THE PROPOSE IMPROVEMENTS SHOWN ON THE PLANS.

BENCHMARKS  
COLLIN COUNTY GPS MONUMENT NO.107  
STATE PLANE COORDINATES: N=7,162,670.5090 E=2,530,072.8220  
ELEVATION=673.03'  
TEMPORARY BENCHMARK  
TOP OF NORTH END OF CONCRETE HEADWALL ON WEST SIDE OF F.M. 543 (WESTON ROAD)  
APPROXIMATELY 1,067' SOUTH OF THE NORTHEAST CORNER OF THE SUBJECT PROPERTY.  
APPROXIMATE STATE PLANE COORDINATES: N=7,166,417.1± E=2,529,937.4±  
ELEVATION=684.71'

LEGEND:


--- DRAINAGE DIVIDE

X  
X.XXX AC  
X.XX CFS

Area Designation  
Acreage  
Q<sub>100</sub>

GRAPHIC SCALE

( IN FEET )  
1 inch = 200 ft.

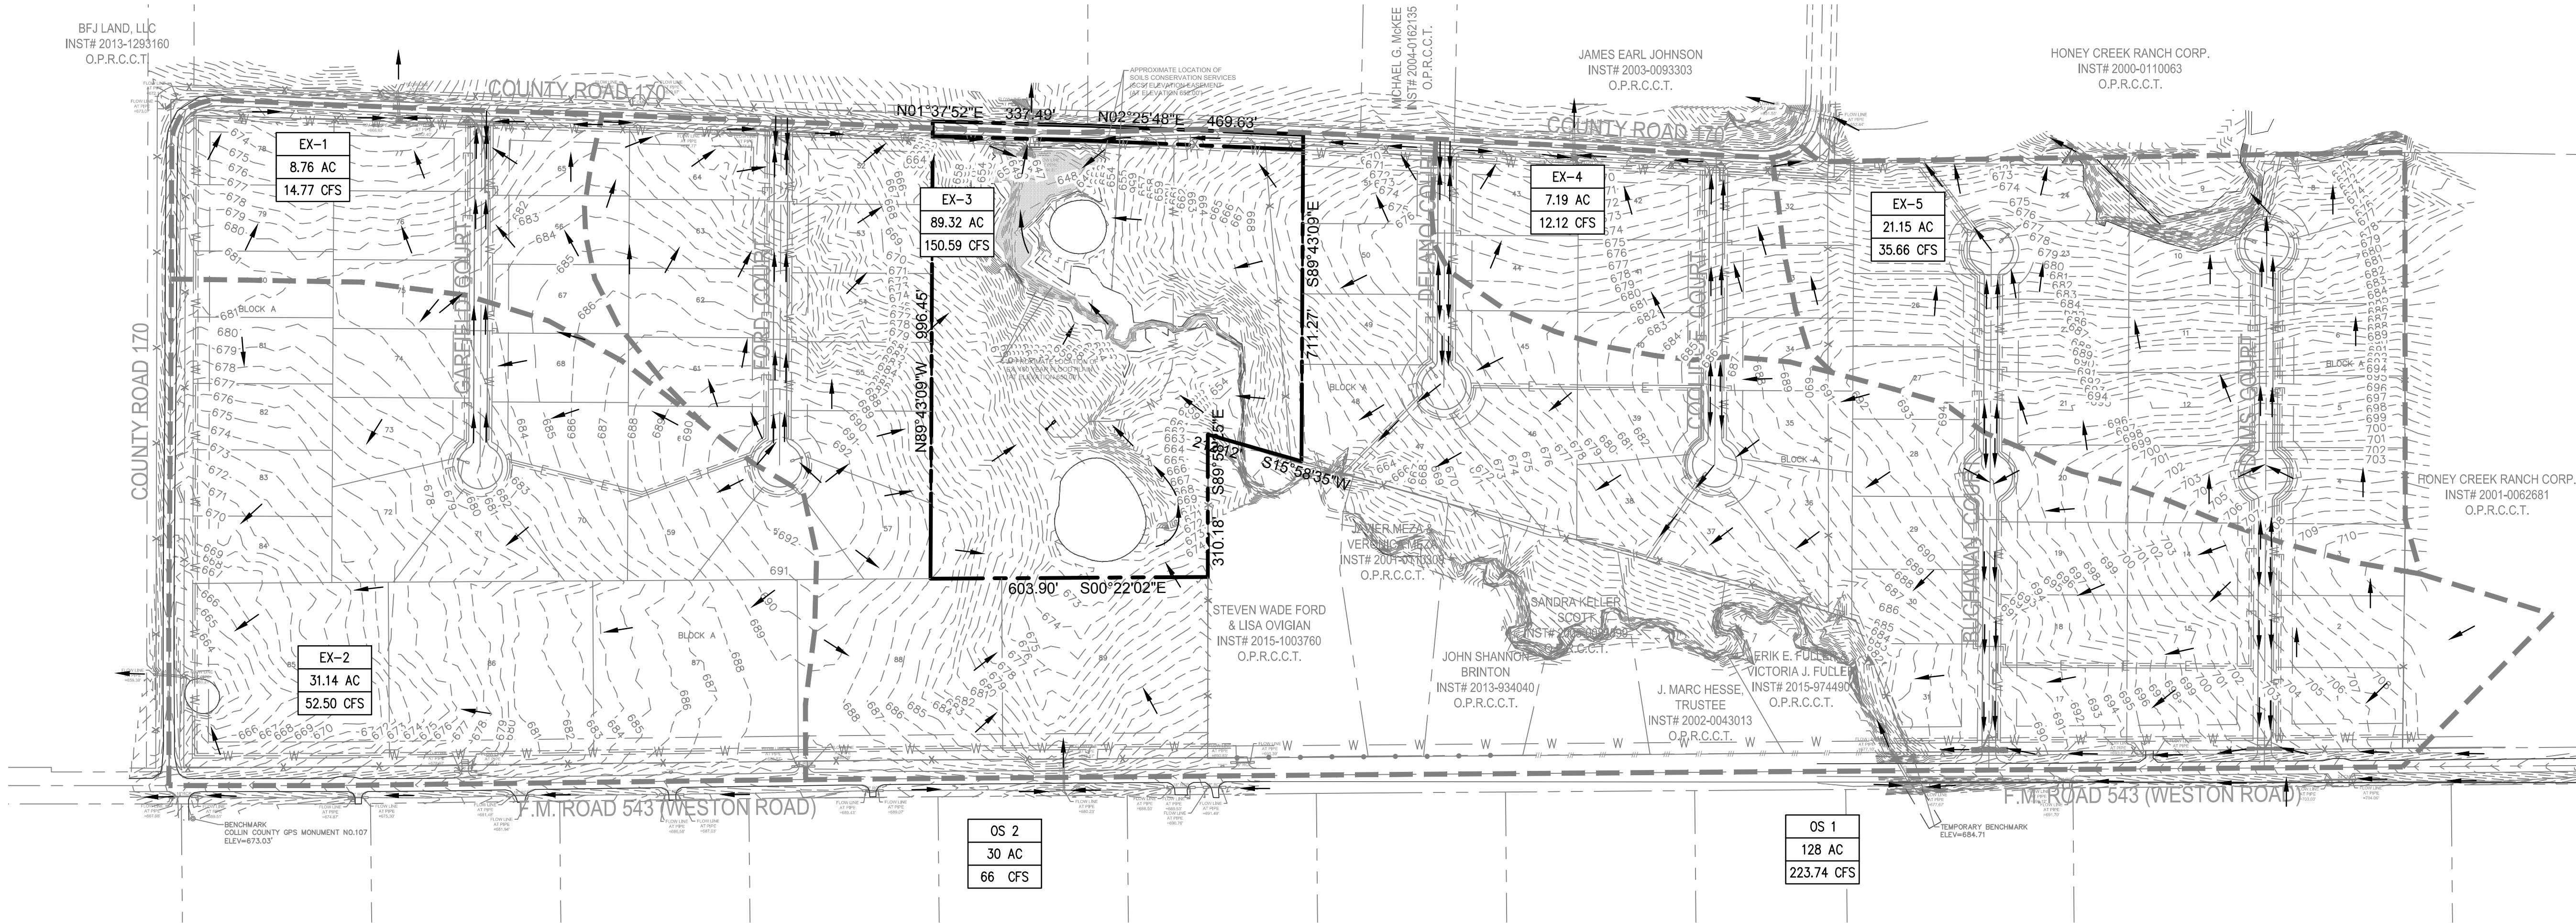

PRE-DEVELOPMENT DRAINAGE AREA COMPUTATIONS

Design Point	Runoff Coef.	Area "A" (Acres)	Time of Concentration (min.)	Intensity I-10yr (in/hr)	Discharge Q-10yr (cfs)	Intensity I-100yr (in/hr)	Discharge Q-100yr (cfs)	Inlet Type
1	2	3	5	8	9	10	11	12
EX-1	0.30	8.76	30	3.89	10.22	5.62	14.77	
EX-2	0.30	31.14	30	3.89	36.34	5.62	52.50	EX. PIPE CULVERT
EX-3	0.30	89.32	30	3.89	104.24	5.62	150.59	EX. PIPE CULVERT
EX-4	0.30	7.19	30	3.89	8.39	5.62	12.12	EX. PIPE CULVERT
EX-5	0.30	21.15	30	3.89	24.68	5.62	35.66	EX. PIPE CULVERT
TOTAL		148.80			173.65		250.88	




AS BUILT  
10/29/2019

THIS RECORD DRAWING IS A COMPILATION OF SEALED ENGINEERING DRAWINGS FOR THIS PROJECT MODIFIED BY INFORMATION FURNISHED BY THE CONTRACTOR, BASED ON THE CONTRACTORS' INFORMATION AND GENERAL INSPECTION BY THE CITY.



5900 S. Lake Forest Dr., Suite 380  
McKinney, TX 75070  
Ph. 214-491-1830  
John Measels, PE  
CIVIL ENGINEER  
FIRM NO. 19504

FIRM NO. F-19504

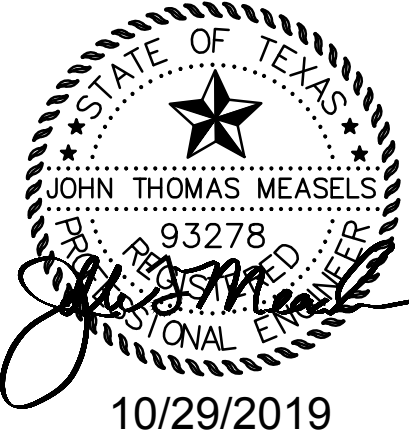

LOT 90, BLOCK A, VAN BUREN ESTATES  
NORTHWEST CORNER OF F.M.543 (WESTON ROAD)  
AND C.R.170 WESTON, TX 75097

REV.	DATE	DESCRIPTION	NAME	TITLE
1	10/29/19	AS BUILT	TWA	
PROJECT NO.	JM-RRY0001.0	DRAWN BY:	TWA	
CHECKED BY:	AS	ISSUE DATE:	10/29/19	



PRE-DEV DRAINAGE AREA MAP

C3.1



CAUTION NOTICE TO CONTRACTOR  
THE CONTRACTOR IS SPECIFICALLY CAUTIONED THAT THE LOCATION AND/OR ELEVATION OF EXISTING UTILITIES AS SHOWN ON THESE PLANS ARE BASED ON RECORDS OF THE VARIOUS UTILITY COMPANIES AND, WHERE POSSIBLE, MEASUREMENTS TAKEN IN THE FIELD. THE INFORMATION IS NOT TO BE RELIED ON AS BEING EXACT OR COMPLETE. THE CONTRACTOR MUST CALL THE APPROPRIATE UTILITY COMPANY AT LEAST 14 DAYS BEFORE ANY EXCAVATION TO REQUEST EXACT FIELD LOCATION OF UTILITIES. IT SHALL BE THE RESPONSIBILITY OF THE CONTRACTOR TO RELOCATE ALL EXISTING UTILITIES WHICH CONFLICT WITH THE PROPOSED IMPROVEMENTS SHOWN ON THE PLANS.

BENCHMARKS  
COLLIN COUNTY GPS MONUMENT NO.107  
STATE PLANE COORDINATES: N=7,162,670.5090 E=2,530,072.8220  
ELEVATION=673.03'  
TEMPORARY BENCHMARK  
TOP OF NORTH END OF CONCRETE HEADWALL ON WEST SIDE OF F.M. 543 (WESTON ROAD)  
APPROXIMATELY 1,067' SOUTH OF THE NORTHEAST CORNER OF THE SUBJECT PROPERTY.  
APPROXIMATE STATE PLANE COORDINATES: N=7,166,417.1± E=2,529,937.4±  
ELEVATION=684.71'

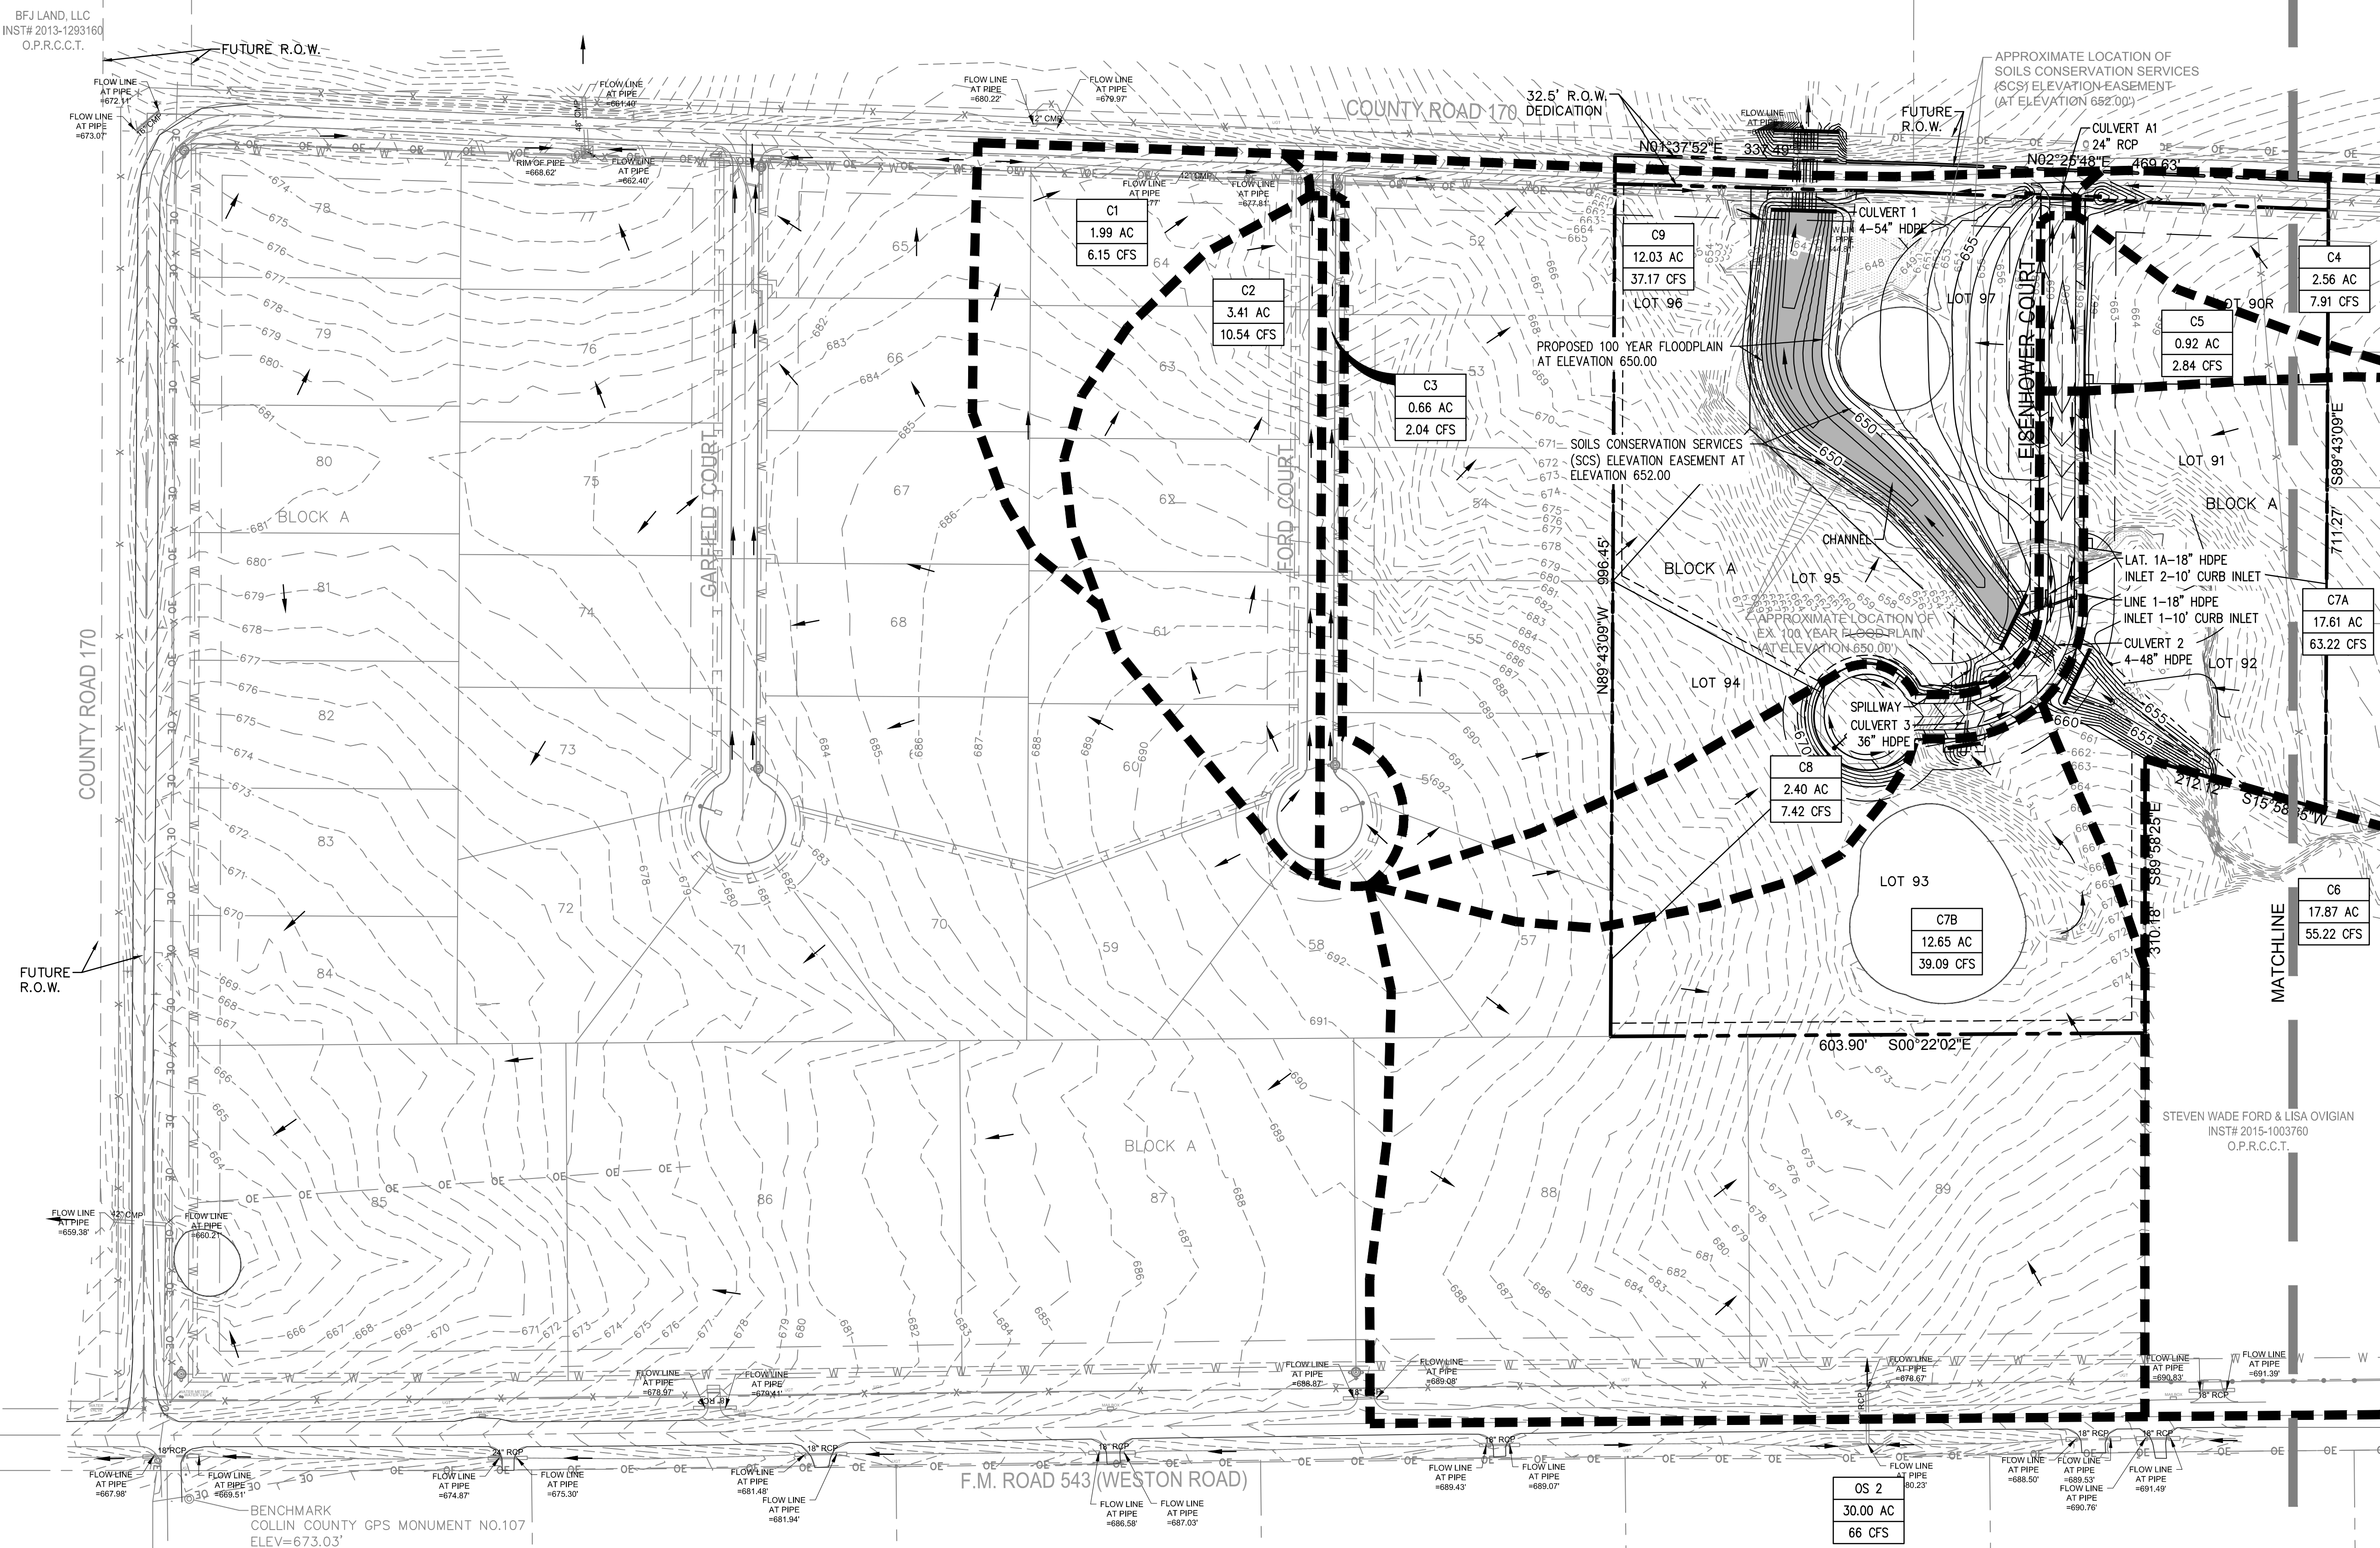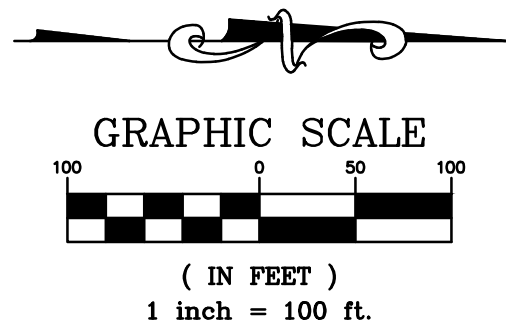

LEGEND:  
--- DRAINAGE DIVIDE  
X Area Designation  
X.XXX AC Acreage  
X.XX CFS  
Q<sub>100</sub>  
ZONING: RED-1

NOTE:  
EXISTING CONDITION 100 YEAR WATER STORAGE VOLUME  
AT ELEVATION 650.00 = 53,403 C.F.  
PROPOSED CONDITION 100 YEAR WATER STORAGE VOLUME  
AT ELEVATION 650.00 = 54,806 C.F.



AS BUILT  
10/29/2019

THIS RECORD DRAWING IS A COMPILATION OF SEALED ENGINEERING DRAWINGS FOR THIS PROJECT MODIFIED BY INFORMATION FURNISHED BY THE CONTRACTOR, BASED ON THE CONTRACTORS' INFORMATION AND GENERAL INSPECTION BY THE CITY.



5900 S. Lake Forest Dr., Suite 380  
McKinney, TX 75070  
Ph. 214-491-1830  
John Measels, PE  
CIVIL ENGINEER  
FIRM NO. 19504

FIRM NO. F-19504  
STATE OF TEXAS  
JOHN THOMAS MEASELS  
93278  
Professional Engineer  
10/29/2019

LOT 90, BLOCK A, VAN BUREN ESTATES  
NORTHWEST CORNER OF F.M.543 (WESTON ROAD)  
AND C.R.170 WESTON, TX 75097

REV	DATE	DESCRIPTION	NAME
1	10/29/19	AS BUILT	TWA
2			
3			
ISSUE DATE:


10/29/19

DRAINAGE AREA MAP (1 OF 2)



BENCHMARKS  
COLLIN COUNTY GPS MONUMENT NO.107  
STATE PLANE COORDINATES: N=7,162,670.5090 E=2,530,072.8220  
ELEVATION=673.03'  
TEMPORARY BENCHMARK  
TOP OF NORTH END OF CONCRETE HEADWALL ON WEST SIDE OF F.M. 543 (WESTON ROAD  
APPROXIMATELY 1,067' SOUTH OF THE THIRDCASE CORNER OF THE SUBJECT PROPERTY.  
APPROXIMATE STATE PLANE COORDINATES: N=7,166,417.1± E=2,529,937.4±  
ELEVATION=684.71'

BENCHMARKS  
COLLIN COUNTY GPS MONUMENT NO.107  
STATE PLANE COORDINATES: N=7,162,670.5090 E=2,530,072.8220  
ELEVATION=673.03'  
TEMPORARY BENCHMARK  
TOP OF NORTH END OF CONCRETE HEADWALL ON WEST SIDE OF F.M. 543 (WESTON ROAD  
APPROXIMATELY 1,067' SOUTH OF THE THIRDCASE CORNER OF THE SUBJECT PROPERTY.  
APPROXIMATE STATE PLANE COORDINATES: N=7,166,417.1± E=2,529,937.4±  
ELEVATION=684.71'

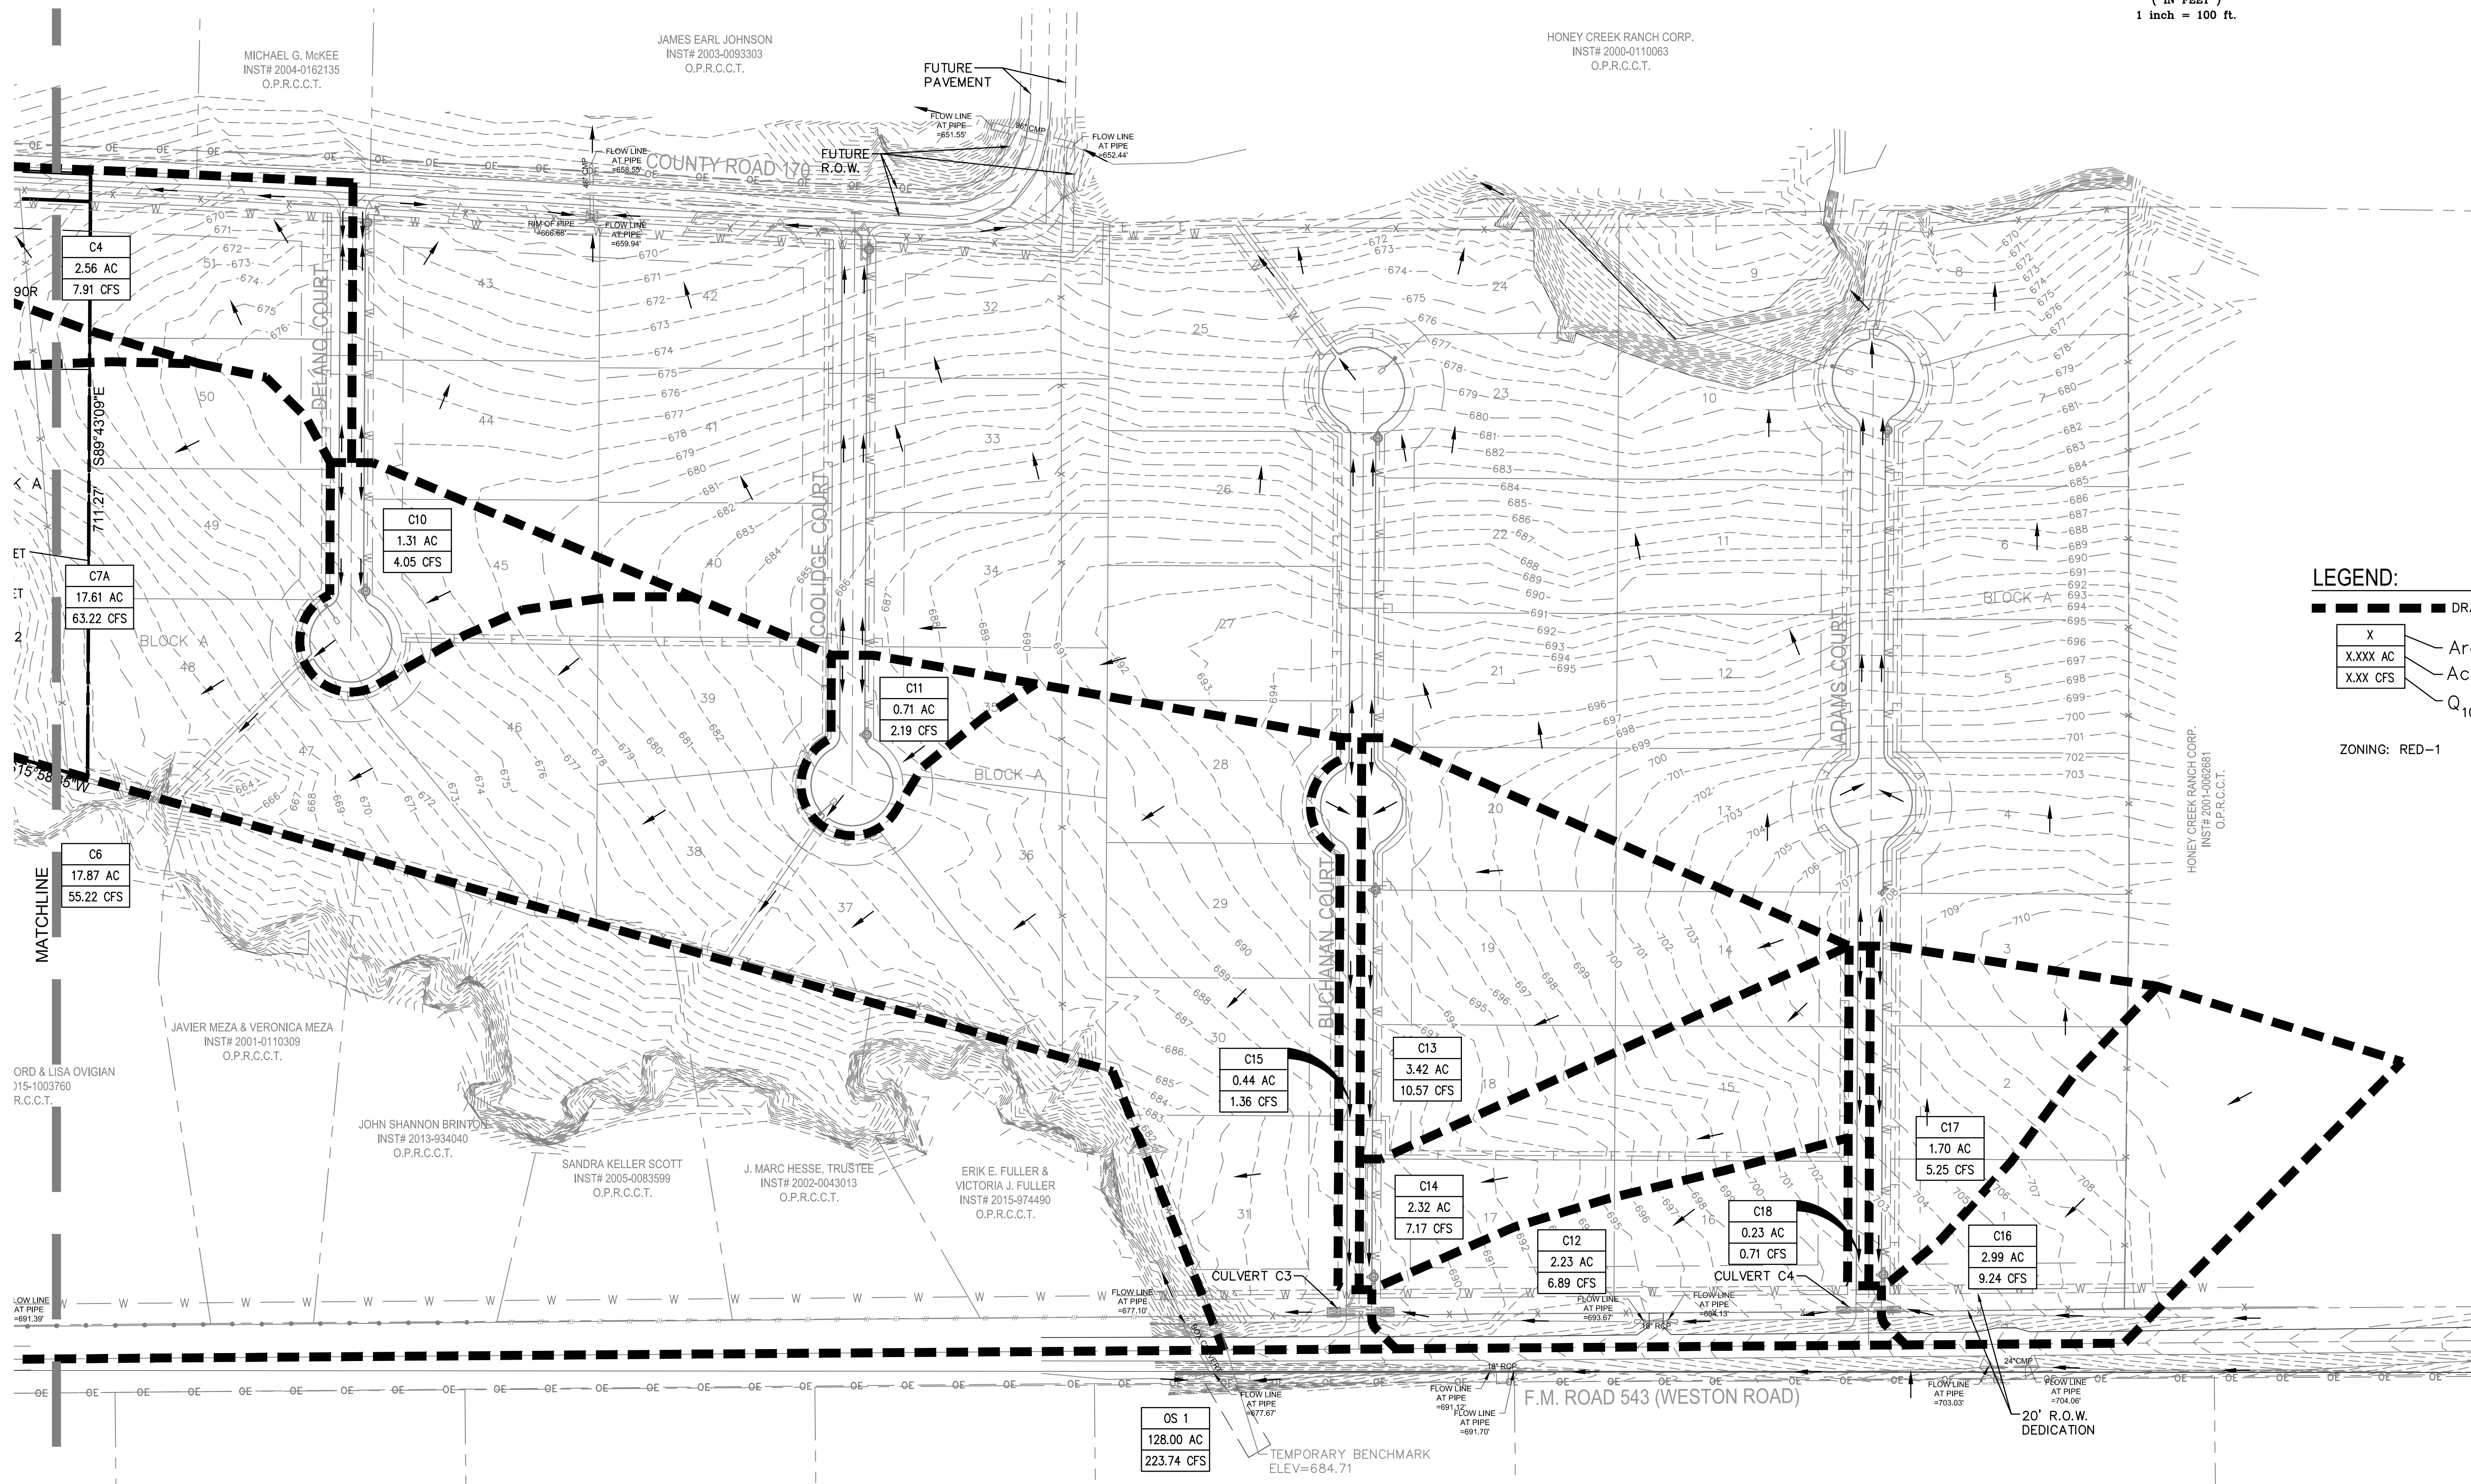

ZONING: RED-1

PROJECT NO:	REV	DATE	DESCRIPTION	NAME
44-RR18001.0		10/29/19	AS BUILT	TWA
DRAWN BY:				
WA				
CHECKED BY:				
S				
ISSUE DATE:				
10/29/19				

### C3.3



**Know what's below.  
Call before you dig.**

AS BUILT  
10/29/2019

THIS RECORD DRAWING IS A COMPILATION OF SEALED ENGINEERING  
DRAWINGS FOR THIS PROJECT MODIFIED BY INFORMATION FURNISHED  
BY THE CONTRACTOR, BASED ON THE CONTRACTORS' INFORMATION  
AND GENERAL INSPECTION BY THE CITY.



J:\PRESIDENTIAL LAND\WESTON, TX - 170 & 543\CURRENT DRAWINGS LOT 90\DRAINAGE LOT 90.DWG 10/30/2019 10:16 AM TIM ANDRIES

POST DEVELOPMENT DRAINAGE AREA COMPUTATIONS FOR CULVERT 1 (4-54")									
Design	Runoff	Area	Time of	Intensity	Discharge	Intensity	Discharge	TOTAL BASIN	
Point	Coef.	"A"	Concentration	I-10yr	Q-10yr	I-100yr	Q-100yr	Q-100yr	
ID	"C"	(Acres)	(min.)	(in/hr)	(cfs)	(in/hr)	(cfs)	(cfs)	
1	2	3	5	8	9	10	11	12	
C1	0.50	1.99	30	3.89	3.87	5.62	5.59	CHANNEL-CULVERT 1	
C2	0.50	3.41	30	3.89	6.63	5.62	9.58	CHANNEL/CULVERT 1	
C3	0.50	0.66	30	3.89	1.28	5.62	1.85	CHANNEL-CULVERT 1	
C4	0.50	2.56	30	3.89	4.98	5.62	7.19	CULVERT A1-CULVERT 1	
C5	0.50	0.92	30	3.89	1.79	5.62	2.59	CHANNEL-CULVERT 1	
C6	0.50	17.87	30	3.89	34.76	5.62	50.21	CULVERT 2-CHANNEL-CULVERT 1	
C7A	0.50	17.61	30	3.89	34.25	5.62	49.48	CULVERT 2-CHANNEL-CULVERT 1	
C7B	0.50	12.65	30	3.89	24.60	5.62	35.55	CULVERT 3-CHANNEL-CULVERT 1	
C8	0.50	2.40	30	3.89	4.67	5.62	6.74	LINE 1, LAT 1A-CHANNEL-CULVERT 1	
C9	0.50	12.03	30	3.89	23.40	5.62	33.80	CHANNEL-CULVERT 1	
C10	0.50	1.31	30	3.89	2.55	5.62	3.68	CULVERT 2-CHANNEL-CULVERT 1	
C11	0.50	0.71	30	3.89	1.38	5.62	2.00	CULVERT 2-CHANNEL-CULVERT 1	
C12	0.50	2.23	30	3.89	4.34	5.62	6.27	CULVERT 2-CHANNEL-CULVERT 1	
C13	0.50	3.42	30	3.89	6.65	5.62	9.61	CULVERT 2-CHANNEL-CULVERT 1	
C14	0.50	2.32	30	3.89	4.51	5.62	6.52	CULVERT 2-CHANNEL-CULVERT 1	
C15	0.50	0.44	30	3.89	0.86	5.62	1.24	CULVERT 2-CHANNEL-CULVERT 1	
C16	0.50	2.99	30	3.89	5.82	5.62	8.40	CULVERT 2-CHANNEL-CULVERT 1	
C17	0.50	1.70	30	3.89	3.31	5.62	4.78	CULVERT 2-CHANNEL-CULVERT 1	
C18	0.50	0.23	30	3.89	0.45	5.62	0.65	CULVERT 2-CHANNEL-CULVERT 1	
TOTAL		87.45			170.09		245.73		
OFFSITE (EAST OF FM 543)	OS 1	0.38	128.00	53	3.2	155.65	4.6	223.74	CULVERT 2-CHANNEL-CULVERT 1
	OS 2	0.38	30.00	36	4.1	46.74	5.8	66.12	CHANNEL-CULVERT 1
	TOTAL		158.00			202.39		289.86	
TOTAL		245.45			372.48		535.60	TOTAL Q INTO CULVERT 1	

RUNOFF CALCULATIONS FOR CULVERT 2 (4-48")									
POST DEVELOPMENT DRAINAGE AREA COMPUTATIONS									
Design	Runoff	Area	Time of	Intensity	Discharge	Intensity	Discharge	TOTAL BASIN	
Point	Coef.	"A"	Concentration	I-10yr	Q-10yr	I-100yr	Q-100yr	Q-100yr	
ID	"C"	(Acres)	(min.)	(in/hr)	(cfs)	(in/hr)	(cfs)	(cfs)	
1	2	3	5	8	9	10	11	12	
C6	0.50	17.87	25	4.31	38.51	6.18	55.22	CULVERT 2-CHANNEL-CULVERT 1	
C7A	0.50	17.61	25	4.31	37.95	7.18	63.22	CULVERT 2-CHANNEL-CULVERT 1	
C10	0.50	1.31	25	4.31	2.82	6.18	4.05	CULVERT 2-CHANNEL-CULVERT 1	
C11	0.50	0.71	25	4.31	1.53	6.18	2.19	CULVERT 2-CHANNEL-CULVERT 1	
C12	0.50	2.23	25	4.31	4.81	6.18	6.89	CULVERT 2-CHANNEL-CULVERT 1	
C13	0.50	3.42	25	4.31	7.37	6.18	10.57	CULVERT 2-CHANNEL-CULVERT 1	
C14	0.50	2.32	25	4.31	5.00	6.18	7.17	CULVERT 2-CHANNEL-CULVERT 1	
C15	0.50	0.44	25	4.31	0.95	6.18	1.36	CULVERT 2-CHANNEL-CULVERT 1	
C16	0.50	2.99	25	4.31	6.44	6.18	9.24	CULVERT 2-CHANNEL-CULVERT 1	
C17	0.50	1.70	25	4.31	3.66	6.18	5.25	CULVERT 2-CHANNEL-CULVERT 1	
C18	0.50	0.23	25	4.31	0.50	6.18	0.71	CULVERT 2-CHANNEL-CULVERT 1	
TOTAL		50.83			109.54		165.87		
OFFSITE (EAST OF FM 543)	OS 1	0.38	128.00	53	3.2	155.65	4.6	223.74	CULVERT 2-CHANNEL-CULVERT 1
	TOTAL		128.00			155.65		223.74	
TOTAL		178.83			265.19		389.61	TOTAL Q INTO CULVERT 2	

RUNOFF CALCULATIONS FOR SPILLWAY CULVERT 3, LINE 1 & LAT. 1A									
POST DEVELOPMENT DRAINAGE AREA COMPUTATIONS									
Design	Runoff	Area	Time of	Intensity	Discharge	Intensity	Discharge	TOTAL BASIN	
Point	Coef.	"A"	Concentration	I-10yr	Q-10yr	I-100yr	Q-100yr	Q-100yr	
ID	"C"	(Acres)	(min.)	(in/hr)	(cfs)	(in/hr)	(cfs)	(cfs)	
1	2	3	5	8	9	10	11	12	
C4	0.50	2.56	10	6.54	8.37	9.20	11.78	CULVERT A1	
C7B	0.50	12.65	10	6.54	41.37	9.20	58.19	CULVERT 3	
C8	0.50	2.40	10	6.54	7.85	9.20	11.04	LINE 1, LAT. 1A	

AS BUILT  
10/29/2019

THIS RECORD DRAWING IS A COMPILATION OF SEALED ENGINEERING DRAWINGS FOR THIS PROJECT MODIFIED BY INFORMATION FURNISHED BY THE CONTRACTOR, BASED ON THE CONTRACTORS' INFORMATION AND GENERAL INSPECTION BY THE CITY.

JM CIVIL

Engineering

5900 S. Lake Forest Dr., Suite 380  
McKinney, TX 75070  
Ph. 214-491-1830  
John Measels, PE  
CIVIL ENGINEER  
FIRM NO. 19504

FIRM NO. F-19504

STATE OF TEXAS

93278

JOHN THOMAS MEASELS

Professional Engineer

10/29/2019

LOT 90, BLOCK A, VAN BUREN ESTATES  
NORTHWEST CORNER OF F.M.543 (WESTON ROAD)  
AND C.R.170 WESTON, TX 75097

NAME: TWA

DESCRIPTION: AS BUILT

DATE: 10/29/19

PROJECT NO: JM-HRY001.0

DRAWN BY: TWA

CHECKED BY: AS

ISSUE DATE: 10/29/19

DRAINAGE CALCULATIONS


C3.4








BENCHMARKS  
COLLIN COUNTY GPS MONUMENT NO.107.  
 STATE PLANE COORDINATES: N=7,162,670.590 E=2,530,072.8220  
 ELEVATION=673.03  
TEMPORARY BENCHMARK  
 TOP OF NORTH END OF CONCRETE HEADWALL ON WEST SIDE OF F.M. 543 (WESTON ROAD)  
 APPROXIMATELY 1,067' SOUTH OF THE NORTHEAST CORNER OF THE SUBJECT PROPERTY.  
 APPROXIMATE STATE PLANE COORDINATES: N=7,166,417.1± E=2,529,937.4±  
 ELEVATION=684.71'

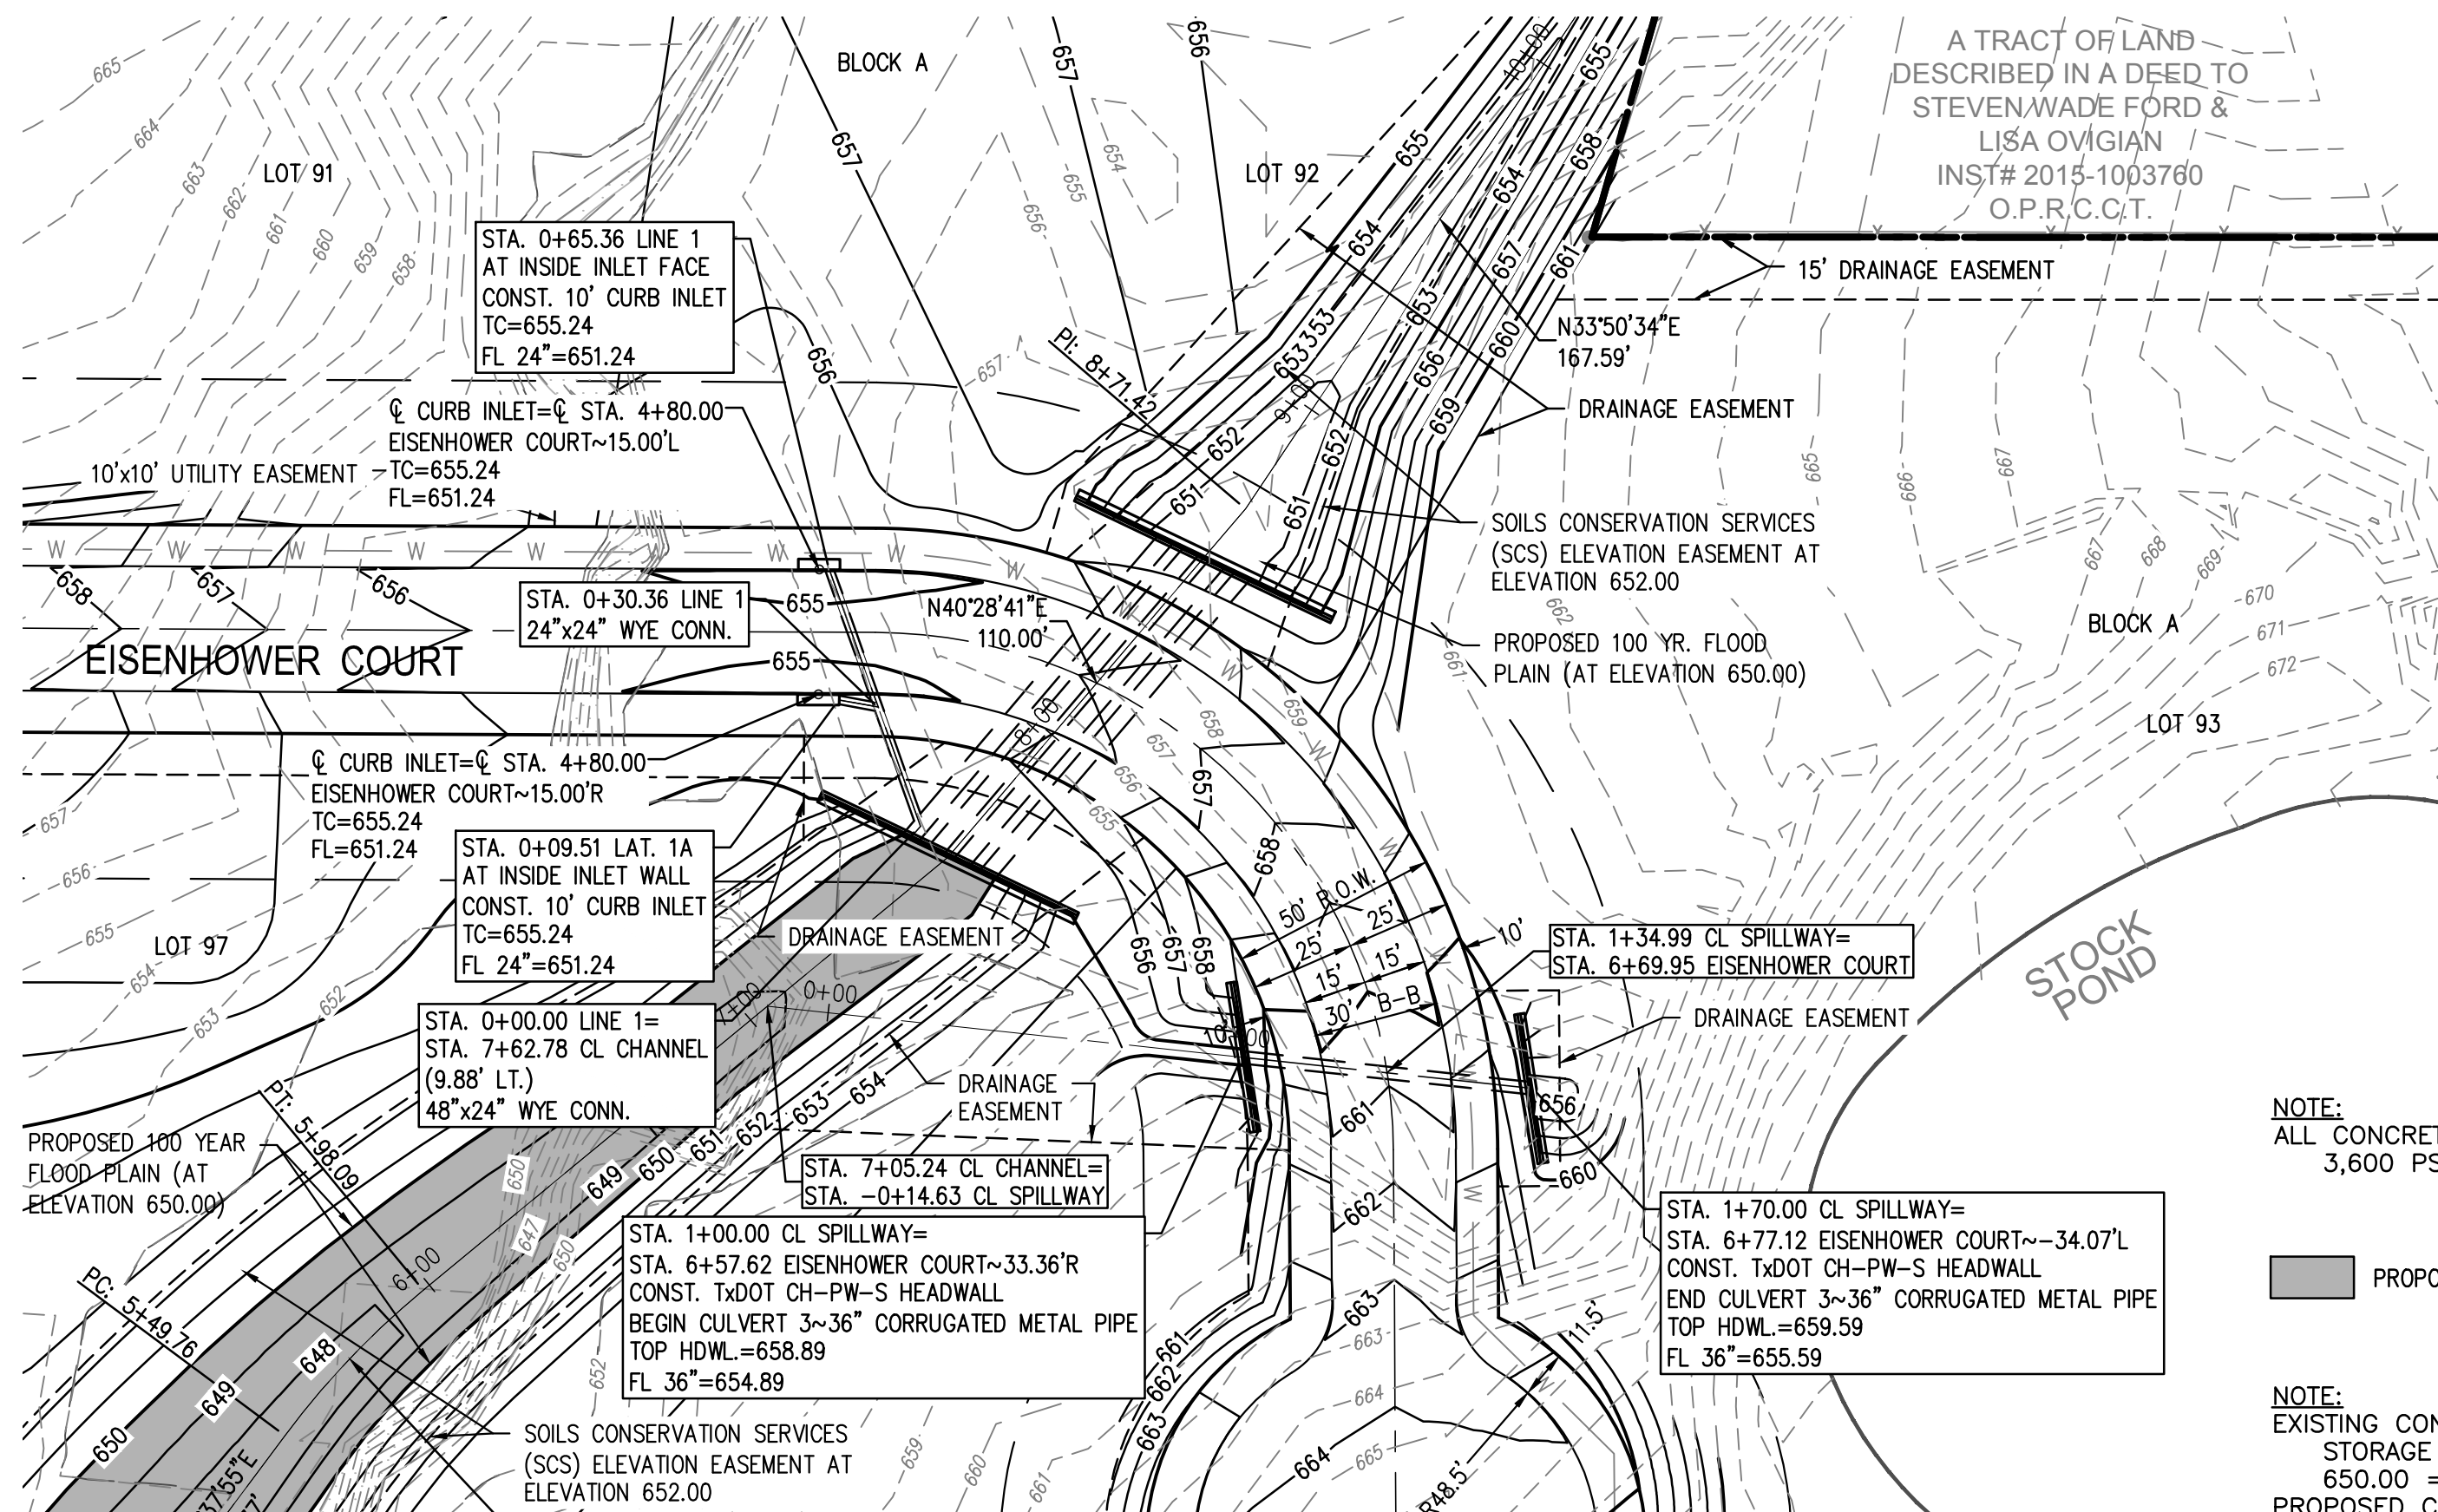

## SPILLWAY, LINE 1 AND LAT. 1A

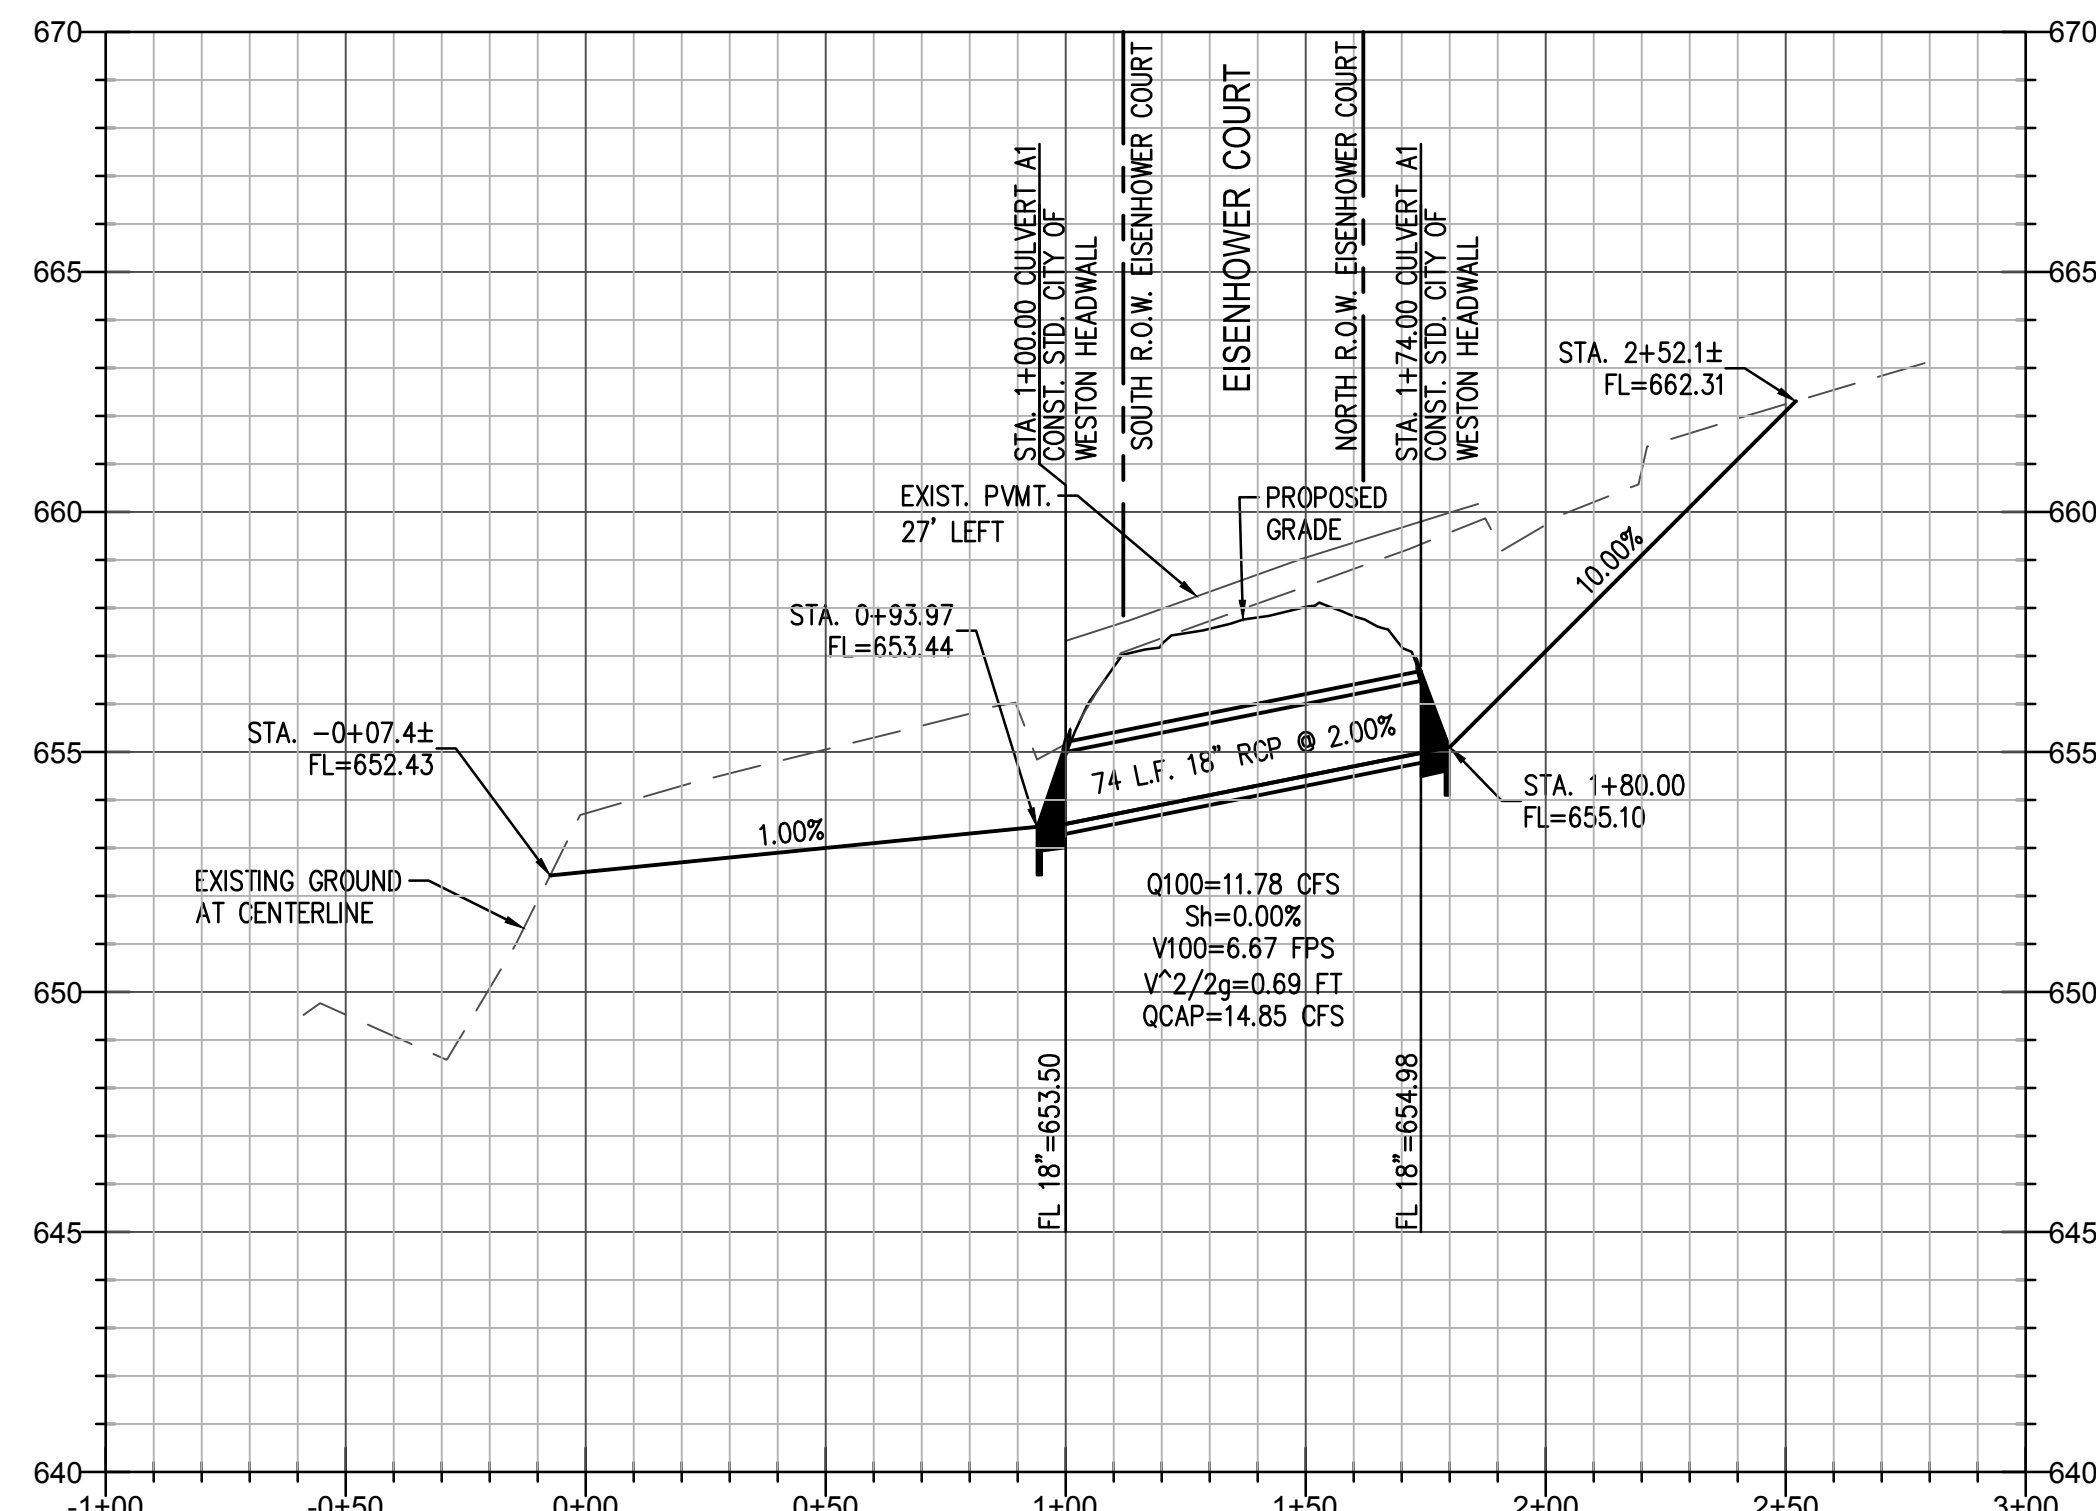

Profile view of Culvert 3. The vertical axis shows elevation in feet (650 to 675). The horizontal axis shows stationing (STA. 6+54.89 to STA. 6+57.62). The profile includes the existing ground (dashed line), the proposed grade (solid line), and the culvert structure (thick black line). Key features include:

- EXISTING GROUND AT CENTERLINE** (dashed line)
- PROPOSED GRADE** (solid line)
- CULVERT 3** (thick black line)
- Q100=94.04 CFS**
- Q1=0.00%**
- V100=13.30 FPS**
- V<sup>2</sup>/2g=2.75 FT**
- QCAP=66.69 CFS**
- STA. 6+54.89** (Left end of culvert)
- STA. 6+57.62** (Right end of culvert)
- CONST. 1:400 CL SILLWAY**
- CONST. 1:400 CH-PW-S HEADWALL**
- BEGIN CULVERT 3'-36" CORRUGATED METAL PIPE**
- WEST R.O.W. EISENHOWER COURT**
- EISENHOWER COURT**
- EAST R.O.W. EISENHOWER COURT**
- CONST. 1:400 CL SILLWAY**
- CONST. 1:400 CH-PW-S HEADWALL**
- END CULVERT 3'-36" CORRUGATED METAL PIPE**
- STA. 6+57.62** (Right end of culvert)

Profile view of EISENHOWER COURT. The vertical axis shows elevation in feet, ranging from 645 to 670. The horizontal axis represents the length of the sewer line.

**EXISTING GROUND AT CENTERLINE** is shown as a solid line. **PROPOSED GRADE** is shown as a dashed line.

**SEWER LINES:**

- 35 L.F. 24" HDPE @ 0.36%** (Q100=5.52 CFS, Sh=0.00%, V100=1.76 FPS, V<sup>2</sup>/2g=0.05 FT, QCAP=13.62 CFS)
- 30 L.F. 24" HDPE @ 0.36%** (Q100=11.04 CFS, Sh=0.00%, V100=3.51 FPS, V<sup>2</sup>/2g=0.19 FT, QCAP=13.62 CFS)

**SEWER MANHOLE DATA:**

- MANHOLE 1:** STA. 04.55.36 LINE 1, STA. 44.82.50 EISENHOWER COURT, -15.00' AT INSIDE INLET FACE, CONST. 10" CORB INLET, STA. 04.30.36 LINE 1=, STA. 04.00.00 LAT. 1A, 24"x24" WYE CONN.
- MANHOLE 2:** STA. 04.00.00 LINE 1=, STA. 74.52.78 CL CHANNEL (9.88' LT.), 48"x24" WYE CONN.

**ADDITIONAL DATA:**

- NORTH R.O.W. EISENHOWER COURT**
- SOUTH R.O.W. EISENHOWER COURT**
- EISENHOWER COURT**
- EL 24'=651.24**
- EL 24'=651.11**
- EL 48'=650.02**
- EL 24'=651.00**




**AS BUILT**  
**10/29/2019**

THIS RECORD DRAWING IS A COMPILATION OF SEALED ENGINEERING DRAWINGS FOR THIS PROJECT MODIFIED BY INFORMATION FURNISHED BY THE CONTRACTOR, BASED ON THE CONTRACTORS' INFORMATION AND GENERAL INSPECTION BY THE CITY.
---

[illegible]

## C4.1



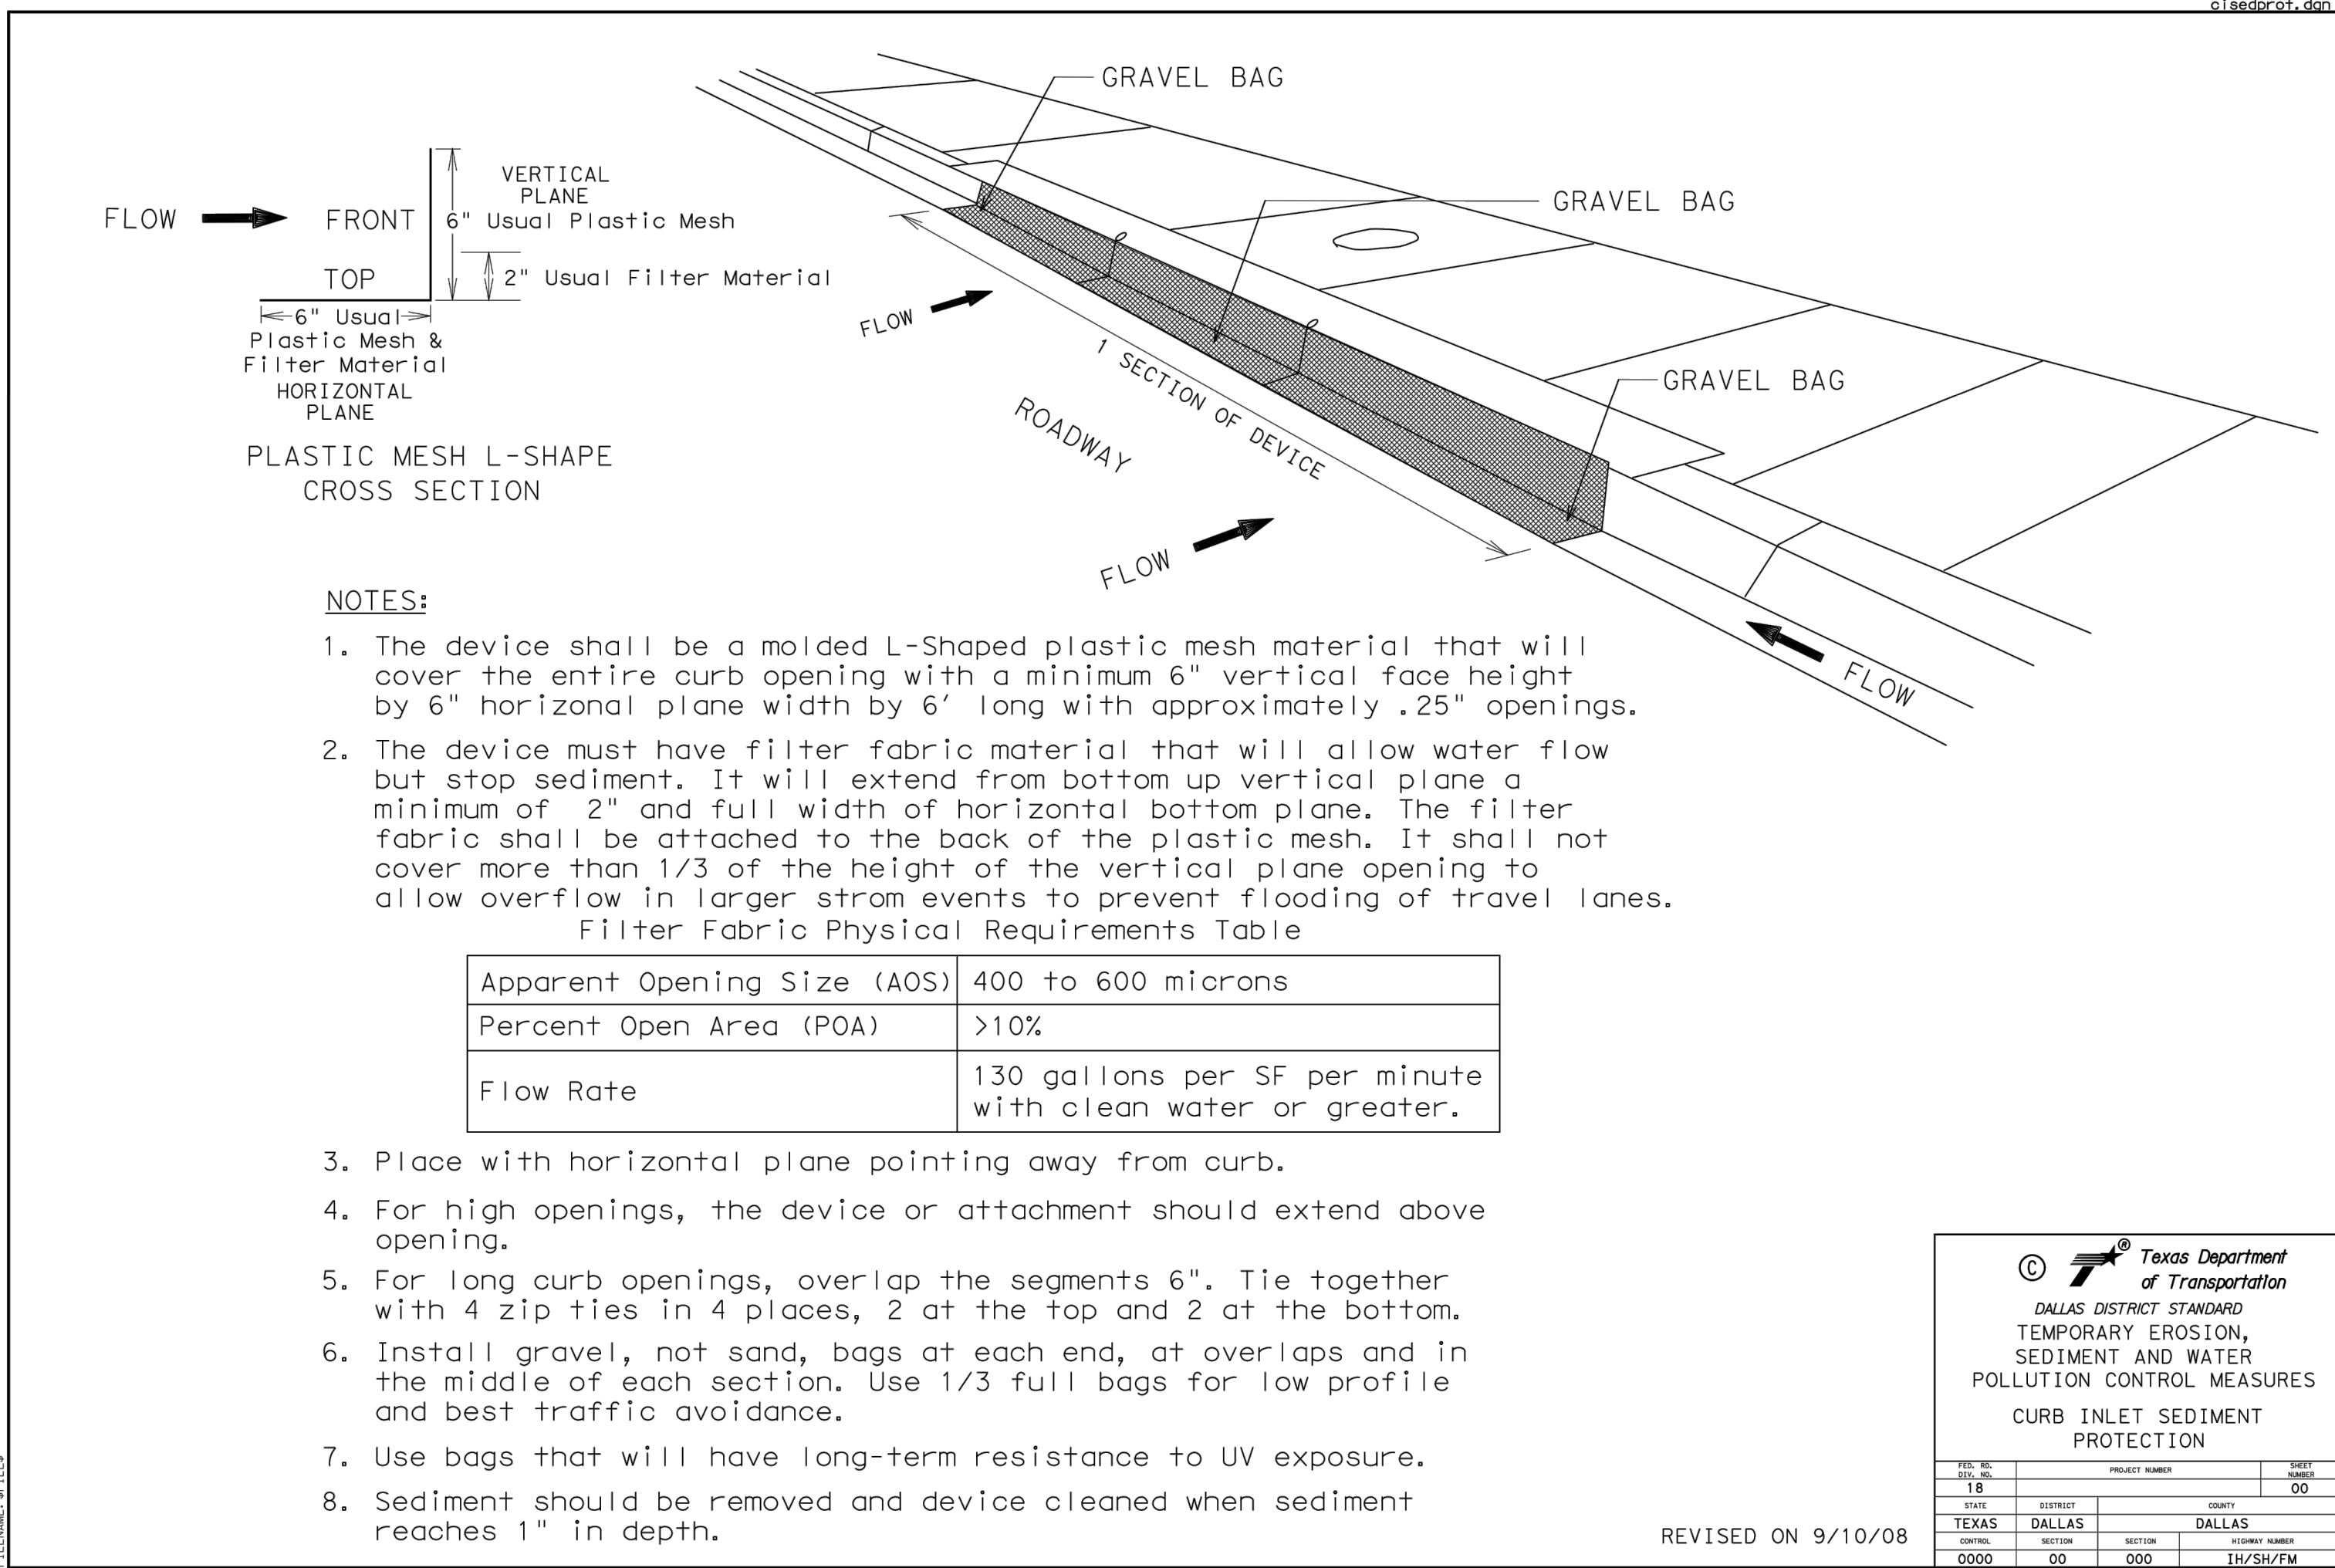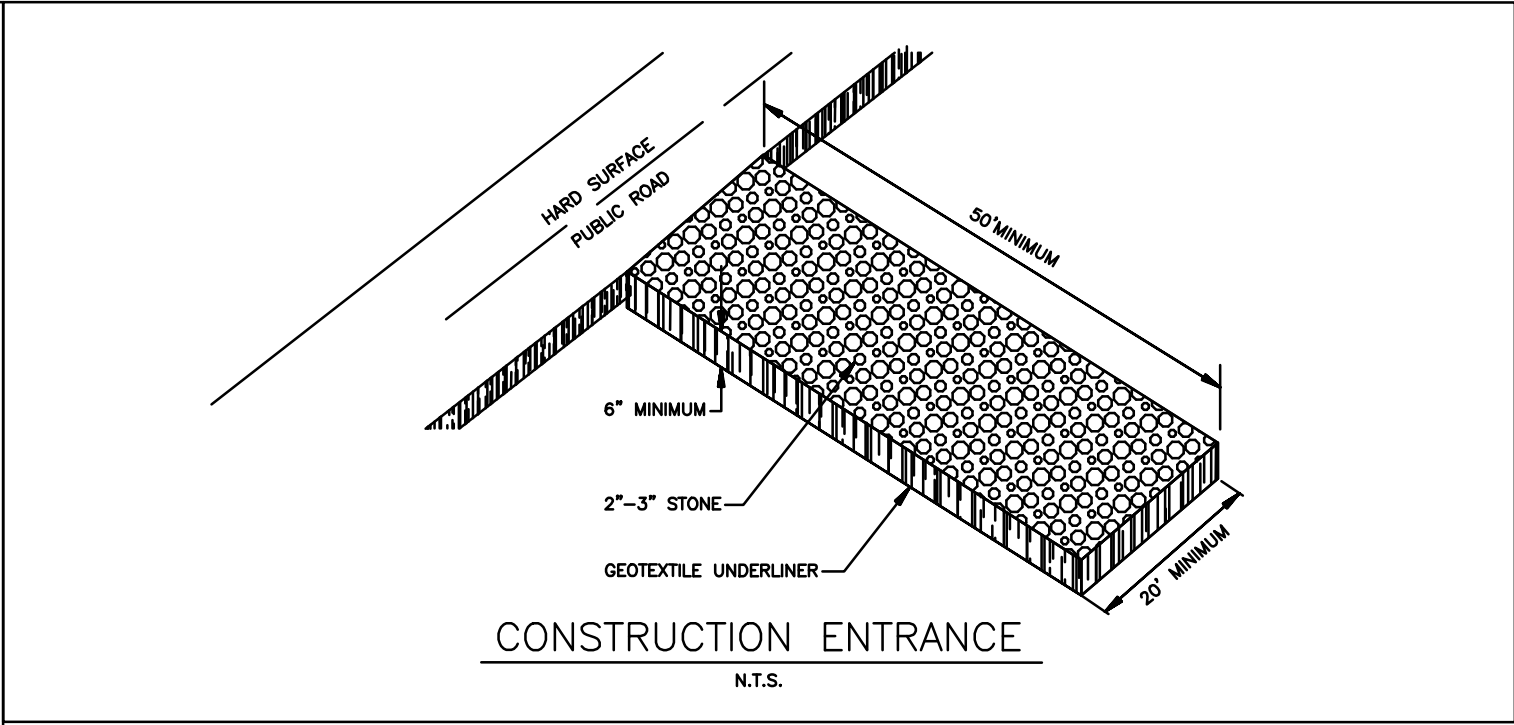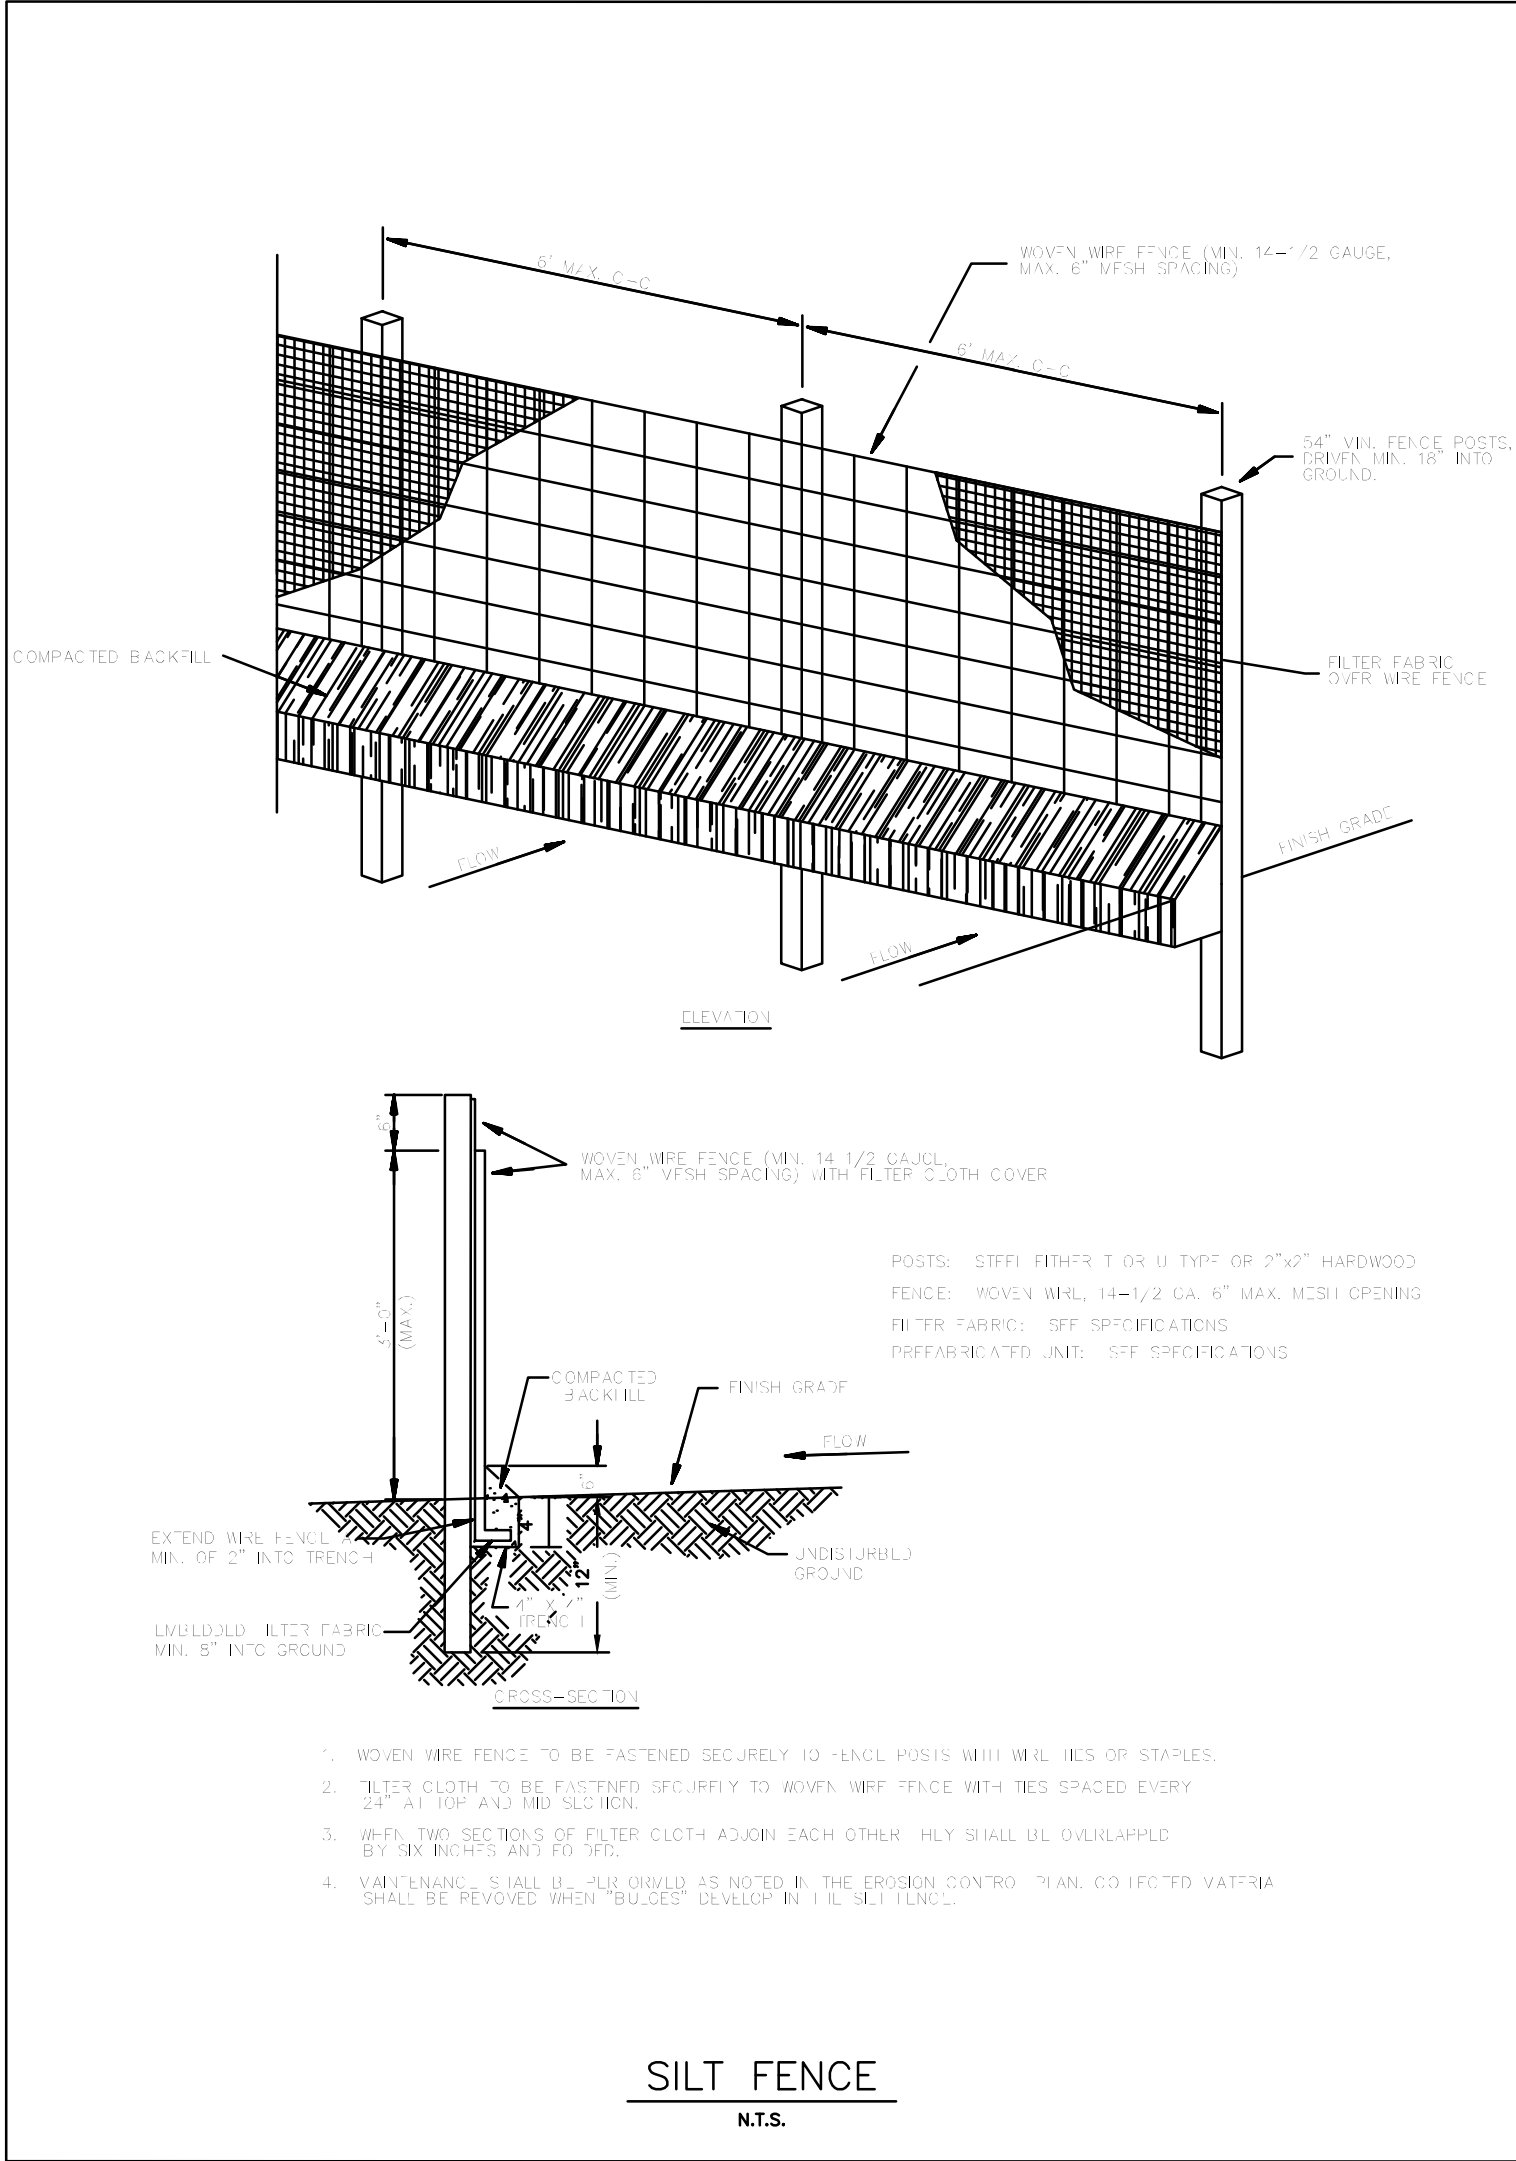

AS BUILT  
10/29/2019

THIS RECORD DRAWING IS A COMPILATION OF SEALED ENGINEERING DRAWINGS FOR THIS PROJECT MODIFIED BY INFORMATION FURNISHED BY THE CONTRACTOR, BASED ON THE CONTRACTORS' INFORMATION AND GENERAL INSPECTION BY THE CITY.

REV	DATE	DESCRIPTION	NAME
1	10/29/19	AS BUILT	TWA
2			
3			
- PRIOR TO STARTING CONSTRUCTION, THE GENERAL CONTRACTOR SHALL BE RESPONSIBLE TO VERIFY THAT ALL NECESSARY PERMITS AND APPROVALS HAVE BEEN OBTAINED. NO CONSTRUCTION SHALL BEGIN UNTIL ALL PERMITS HAVE BEEN RECEIVED.
2. SITE BOUNDARY, TOPOGRAPHY, UTILITY AND ROAD INFORMATION WAS TAKEN FROM A SURVEY BY TEXAS HERITAGE SURVEYING, LLC, 10610 METRIC DRIVE, SUITE 124, DALLAS, TX 75243. PHONE: (214) 340-9700.
3. IF THE CONTRACTOR, IN THE COURSE OF THE WORK, FINDS ANY DISCREPANCIES BETWEEN THE PLANS AND THE PHYSICAL CONDITIONS OF THE LOCALITY, OR ANY ERRORS OR OMISSIONS IN THE PLANS OR IN THE LAYOUT AS GIVEN BY THE ENGINEER, IT SHALL BE HIS DUTY TO IMMEDIATELY INFORM THE ENGINEER, IN WRITING, AND THE ENGINEER WILL PROMPTLY VERIFY THE SAME. ANY WORK DONE AFTER SUCH A DISCOVERY, UNTIL AUTHORIZED, WILL BE AT THE CONTRACTOR'S RISK.
4. CONTRACTOR SHALL REFER TO THE ARCHITECTURAL PLANS FOR EXACT LOCATIONS AND DIMENSIONS OF VESTIBULES, SLOPE PAVING, SIDEWALKS, EXIT PORCHES, TRUCK DOCKS, PRECISE BUILDING DIMENSIONS AND EXACT BUILDING UTILITY ENTRANCE LOCATIONS.
5. CONTRACTOR SHALL BE RESPONSIBLE FOR VERIFICATION OF ALL SETBACKS, EASEMENTS, AND DIMENSIONS SHOWN HEREON BEFORE BEGINNING CONSTRUCTION.
6. ALL CONSTRUCTION MATERIALS AND WORKMANSHIP SHALL BE IN ACCORDANCE TO THE STATE AND AUTHORITY HAVING JURISDICTION (AHJ) LATEST CONSTRUCTION SPECIFICATIONS AND DETAILS.
7. ALL HANDICAP SITE FEATURES SHALL BE CONSTRUCTED TO MEET ALL FEDERAL, STATE AND AHJ CODE.
8. NOTIFY THE CITY INSPECTOR TWENTY-FOUR (24) HOURS BEFORE BEGINNING EACH PHASE OF CONSTRUCTION.
9. THE CONTRACTOR SHALL CAREFULLY PRESERVE BENCHMARKS, REFERENCE POINTS, AND STAKES.
10. ARCHITECTURAL AND STRUCTURAL PLANS ARE TO BE USED FOR BUILDING STAKE OUT.
11. ALL DIMENSIONS ARE FROM FACE OF BUILDING, CURB, AND WALL UNLESS OTHERWISE SPECIFIED ON PLANS.
12. CONTRACTOR SHALL MAINTAIN THE SITE IN A MANNER SO THAT WORKMEN AND PUBLIC SHALL BE PROTECTED FROM INJURY, AND ADJOINING PROPERTY PROTECTED FROM DAMAGE.
13. CONTRACTOR IS RESPONSIBLE FOR DAMAGE TO ANY EXISTING ITEM AND/OR MATERIAL INSIDE OR OUTSIDE CONTRACT LIMITS DUE TO CONSTRUCTION OPERATION.
14. ALL STREET SURFACES, DRIVEWAYS, CULVERTS, CURB AND GUTTERS, ROADSIDE DRAINAGE DITCHES AND OTHER STRUCTURES THAT ARE DISTURBED OR DAMAGED IN ANY MANNER AS A RESULT OF CONSTRUCTION SHALL BE REPLACED OR REPAIRED IN ACCORDANCE WITH THE SPECIFICATIONS.
15. FOR WORK IN, OR ADJACENT TO, HIGHWAY RIGHT OF WAYS, CONTRACTOR SHALL ENSURE APPROPRIATE PERMITS ARE OBTAINED PRIOR TO CONSTRUCTION. CONTRACTOR TO ERECT AND MAINTAIN TRAFFIC CONTROL SIGNS AND DEVICES IN CONFORMANCE WITH THE STATE MANUAL OF TRAFFIC CONTROL DEVICES, LATEST EDITION, ALONG WITH THE REQUIREMENTS OF THE LOCAL D.O.T. AREA OFFICE.
16. ALL CURB RADII SHALL BE 3' OR 10' UNLESS OTHERWISE NOTED ON THE PLANS.
17. DIMENSIONS AND RADII ARE TO THE FACE OF CURB UNLESS OTHERWISE NOTED.

1. CONTRACTOR MUST SECURE ALL NECESSARY PERMITS PRIOR TO STARTING WORK.
2. REFER TO GEOTECH REPORT FOR PREPARATION OF THE SUBGRADE.
3. ALL HANDICAP PARKING SPACES SHALL BE CONSTRUCTED TO MEET ALL FEDERAL, STATE AND AUTHORITY HAVING JURISDICTION (AHJ) CODE.
4. ALL ROAD WORK SHALL BE PERFORMED IN ACCORDANCE WITH THE STATE AND (AHJ) SPECIFICATIONS.

1. ALL CONTRACTORS AND SUBCONTRACTORS INVOLVED WITH STORM WATER POLLUTION PREVENTION SHALL OBTAIN A COPY OF THE STORM WATER POLLUTION PREVENTION PLAN AND BECOME FAMILIAR WITH AUTHORITY HAVING JURISDICTION (AHJ) REGULATION AND PERMITTING.
2. CONTRACTOR SHALL IMPLEMENT BEST MANAGEMENT PRACTICES AS REQUIRED BY THE SWPPP. ADDITIONAL BEST MANAGEMENT PRACTICES SHALL BE IMPLEMENTED AS DICTATED BY CONDITIONS AT NO ADDITIONAL COST OF OWNER THROUGHOUT ALL PHASES OF CONSTRUCTION.
3. BEST MANAGEMENT PRACTICES (BMP'S) AND CONTROLS SHALL CONFORM TO FEDERAL, STATE, OR (AHJ) REQUIREMENTS OR MANUAL OF PRACTICE, AS APPLICABLE CONTRACTOR SHALL IMPLEMENT ADDITIONAL CONTROLS AS DIRECTED BY PERMITTING AGENCY OR OWNER.
4. SITE MAP MUST CLEARLY DELINEATE ALL STATE WATERS. PERMITS FOR ANY CONSTRUCTION ACTIVITY IMPACTING STATE WATERS OR REGULATED WETLANDS MUST BE MAINTAINED ON SITE AT ALL TIMES.
5. CONTRACTOR SHALL MINIMIZE CLEARING TO THE MAXIMUM EXTENT PRACTICAL OR AS REQUIRED BY THE GENERAL PERMIT.
6. GENERAL CONTRACTOR SHALL DENOTE ON PLAN THE TEMPORARY PARKING AND STORAGE AREA WHICH SHALL ALSO BE USED AS THE EQUIPMENT MAINTENANCE AND CLEANING AREA, EMPLOYEE PARKING AREA, AND AREA FOR LOCATING PORTABLE FACILITIES, OFFICE TRAILERS, AND TOILET FACILITIES.
7. ALL WASH WATER (CONCRETE TRUCKS, VEHICLE CLEANING, EQUIPMENT CLEANING, ETC.) SHALL BE DETAINED AND PROPERLY TREATED OR DISPOSED.

- SUFFICIENT OIL AND GREASE ABSORBING MATERIALS AND FLOTATION BOOMS SHALL BE MAINTAINED ON SITE OR READILY AVAILABLE TO CONTAIN AND CLEAN-UP FUEL OR CHEMICAL SPILLS AND LEAKS.
  - DUST ON THE SITE SHALL BE CONTROLLED. THE USE OF MOTOR OILS AND OTHER PETROLEUM BASED OR TOXIC LIQUIDS FOR DUST SUPPRESSION OPERATIONS IS PROHIBITED.
  - RUBBISH, TRASH, GARBAGE, LITTER, OR OTHER SUCH MATERIALS SHALL BE DEPOSITED INTO SEALED CONTAINERS. MATERIALS SHALL BE PREVENTED FROM LEAVING THE PREMISES THROUGH THE ACTION OF WIND OR STORMWATER DISCHARGE INTO DRAINAGE DITCHES OR WATERS OF THE STATE.
  - ALL STORM WATER POLLUTION PREVENTION MEASURES PRESENTED ON THIS PLAN SHALL BE INITIATED AS SOON AS PRACTICABLE.
  - DISTURBED PORTIONS OF THE SITE WHERE CONSTRUCTION ACTIVITY HAS STOPPED FOR AT LEAST 14 DAYS, SHALL BE TEMPORARILY SEEDED. THESE AREAS SHALL BE SEEDED NO LATER THAN 14 DAYS FROM THE LAST CONSTRUCTION ACTIVITY OCCURRING IN THESE AREAS.
  - DISTURBED PORTIONS OF THE SITE WHERE CONSTRUCTION ACTIVITY HAS PERMANENTLY STOPPED SHALL BE PERMANENTLY SEEDED. THESE AREAS SHALL BE SEEDED NO LATER THAN 14 DAYS AFTER THE LAST CONSTRUCTION ACTIVITY OCCURRING IN THESE AREAS. REFER TO THE GRADING PLAN AND/OR LANDSCAPE PLAN.
  - IF THE ACTION OF VEHICLES TRAVELING OVER THE GRAVEL CONSTRUCTION ENTRANCES IS NOT SUFFICIENT TO REMOVE THE MAJORITY OF DIRT OR MUD, THEN THE TIRES MUST BE WASHED BEFORE THE VEHICLES ENTER A PUBLIC ROAD. IF WASHING IS USED, PROVISIONS MUST BE MADE TO INTERCEPT THE WASH WATER AND TRAP THE SEDIMENT BEFORE IT IS CARRIED OFF THE SITE.
  - ALL MATERIALS SPILLED, DROPPED, WASHED, OR TRACKED FROM VEHICLES ONTO ROADWAYS OR INTO STORM DRAINS MUST BE REMOVED IMMEDIATELY.
  - CONTRACTORS OR SUBCONTRACTORS WILL BE RESPONSIBLE FOR REMOVING SEDIMENT IN THE DETENTION POND AND ANY SEDIMENT THAT MAY HAVE COLLECTED IN THE STORM SEWER DRAINAGE SYSTEMS IN CONJUNCTION WITH THE STABILIZATION OF THE SITE.
  - ON-SITE & OFFSITE SOIL STOCKPILE AND BORROW AREAS SHALL BE PROTECTED FROM EROSION AND SEDIMENTATION THROUGH IMPLEMENTATION OF BEST MANAGEMENT PRACTICES. STOCKPILE AND BORROW AREA LOCATIONS SHALL BE NOTED ON THE SITE MAP AND PERMITTED IN ACCORDANCE WITH GENERAL PERMIT REQUIREMENTS.
  - SLOPES SHALL BE LEFT IN A ROUGHENED CONDITION DURING THE GRADING PHASE TO REDUCE RUNOFF VELOCITIES AND EROSION. SLOPES LEFT EXPOSED WILL, WITHIN 14 CALENDAR DAYS OF COMPLETION OF ANY PHASE OF GRADING, BE PLANTED OR OTHERWISE PROVIDED WITH TEMPORARY OR PERMANENT EROSION COVER, DEVICES, OR STRUCTURES SUFFICIENT TO RESTRAIN EROSION.
  - DUE TO THE GRADE CHANGES DURING THE DEVELOPMENT OF THE PROJECT, THE CONTRACTOR SHALL BE RESPONSIBLE FOR ADJUSTING THE EROSION CONTROL MEASURES (SILT FENCES, STRAW BALES, ETC.) TO PREVENT EROSION.
  - ALL CONSTRUCTION SHALL BE STABILIZED AT THE END OF EACH WORKING DAY, THIS INCLUDES BACKFILLING OF TRENCHES FOR UTILITY CONSTRUCTION AND PLACEMENT OF GRAVEL OR BITUMINOUS PAVING FOR ROAD CONSTRUCTION.
  - ALL EXISTING UTILITIES WITHIN THE EXISTING BEAMS, PILES, PROPOSED UTILITIES AND TRENCH BACKFILLED AND COMPACTED IN ACCORDANCE WITH THE SPECIFICATIONS AND GEOTECHNICAL REPORT.
  - FOUNDATIONS, FLOORS, FLOOR SLABS, AND ANY OTHER UNDERGROUND BUILDING STRUCTURES SHALL BE REMOVED IN ACCORDANCE WITH THE SPECIFICATIONS. AREAS OF STRUCTURE REMOVAL SHALL BE BACKFILLED IN ACCORDANCE WITH SPECIFICATIONS AND THE GEOTECHNICAL REPORT.
  - DEBRIS SHALL NOT BE BURIED ON THE SUBJECT SITE. ALL UNSUITABLE MATERIAL AND DEBRIS SHALL BE REMOVED FROM THE SITE AND DISPOSED OF IN ACCORDANCE WITH ALL CITY, STATE, AND FEDERAL LAWS AND ORDINANCES.
  - ALL MATERIAL, EXCEPT THAT BELONGING TO A PUBLIC UTILITY COMPANY OR DENOTED FOR SALVAGE, SHALL BECOME PROPERTY OF THE CONTRACTOR. THE CONTRACTOR SHALL NOTIFY THE OWNER OF WATER, ELECTRIC, OR GAS METERS WHEN THE METERS ARE READY FOR REMOVAL, AND THE CONTRACTOR SHALL BE RESPONSIBLE FOR DISCONNECTING ALL UTILITIES IN COMPLIANCE WITH LOCAL REQUIREMENTS. DISCONNECT TRANSFORMERS AS REQUIRED FOR BUILDING DEMOLITION.
  - AS SOON AS DEMOLITION WORK HAS BEEN COMPLETED, THE FINAL GRADE OF BACKFILL IN DEMOLITION AREAS SHALL BE COMPACTED PER THE GEOTECHNICAL REPORT TO PRESENT A NEAT, WELL DRAINED APPEARANCE, AND TO PREVENT WATER FROM DRAINING UNNECESSARILY ONTO ADJACENT PROPERTIES. THE CONTRACTOR SHALL GRADE SITE TO EXISTING STORM DRAINAGE SYSTEM TO REMAIN ON SITE.
  - EXISTING TREES TO REMAIN SHOULD BE PROTECTED FROM DAMAGE DURING DEMOLITION AND CONSTRUCTION.
  - THE CONTRACTOR IS TO COORDINATE WORK IN THIS PROJECT TO ENSURE ACCESS TO ADJACENT PROPERTIES AT ALL TIMES.
  - REMOVAL OF ANY EXISTING PAVEMENT SHALL BE TO THE NEAREST PAVEMENT JOINT (THE ENTIRE CONCRETE PANEL NEEDS TO BE REMOVED AND REPLACED).
- ### GENERAL GRADING/DRAINAGE NOTES:
- ALL GRADING AND SITE PREPARATION SHALL CONFORM WITH SPECIFICATIONS CONTAINED IN THE GEOTECHNICAL REPORT.
  - ALL CONSTRUCTION MATERIALS AND WORKMANSHIP SHALL BE IN ACCORDANCE TO THE AUTHORITY HAVING JURISDICTION (AHJ) LATEST CONSTRUCTION SPECIFICATIONS AND DETAILS.
  - PRIOR TO ANY EXCAVATION OF THE PROJECT SITE, THE CONTRACTOR SHALL NOTIFY THE (AHJ) 48 HOURS PRIOR TO THE START OF CONSTRUCTION.
  - THE CONTRACTOR SHALL CAREFULLY PRESERVE BENCHMARKS, REFERENCE POINTS AND STAKES.
  - ALL INDICATED ELEVATIONS ARE FINISHED ELEVATIONS.
  - FIELD VERIFY LOCATIONS, SIZES AND IF APPLICABLE INVERTS OF EXISTING UTILITIES FOR PROPOSED CONNECTIONS PRIOR TO CONSTRUCTION.

1. ANY DEMOLITION IS TO BE PERFORMED IN STRICT CONFORMANCE WITH ALL APPLICABLE CITY, COUNTY AND STATE, AND/OR AUTHORITY HAVING JURISDICTION (AHL) STANDARDS.
2. THE DEMOLITION PLAN SHALL BE DONE IN CONJUNCTION WITH THE GEOTECHNICAL INVESTIGATION REPORT.
3. EROSION AND SEDIMENT CONTROL MEASUREMENTS SHALL BE MAINTAINED AT ALL TIMES DURING DEMOLITION.
4. THE PURPOSE OF THIS DRAWING IS TO CONVEY THE OVERALL SCOPE OF WORK AND IT IS NOT INTENDED TO COVER ALL DETAILS OR SPECIFICATIONS REQUIRED TO COMPLY WITH GENERALLY ACCEPTED DEMOLITION PRACTICES. CONTRACTOR SHALL THOROUGHLY FAMILIARIZE HIMSELF WITH THE SITE, SCOPE OF WORK, AND ALL EXISTING CONDITIONS AT THE JOB SITE PRIOR TO BIDDING AND COMMENCING THE WORK. THE DEMOLITION CONTRACTOR SHALL BE SOLELY RESPONSIBLE FOR MEANS, METHODS, TECHNIQUES, OR PROCEDURES USED TO COMPLETE THE WORK IN ACCORDANCE WITH THE CONSTRUCTION DOCUMENTS AND IS LIABLE FOR THE SAFETY OF THE PUBLIC OR CONTRACTOR'S EMPLOYEES DURING THE COURSE OF THE PROJECT.

5. THE DEMOLITION PLAN IS INTENDED TO SHOW REMOVAL OF KNOWN SITE FEATURES AND UTILITIES AS SHOWN ON THE SURVEY. THERE MAY BE OTHER SITE FEATURES, UTILITIES, STRUCTURES, AND MISCELLANEOUS ITEMS BOTH BURIED AND ABOVE GROUND THAT ARE WITHIN THE LIMITS OF WORK THAT MAY NEED TO BE REMOVED FOR THE PROPOSED PROJECT THAT ARE NOT SHOWN HEREON. THE CONTRACTOR IS RESPONSIBLE FOR THE REMOVAL OF SUCH ITEMS AT NO ADDITIONAL COST TO THE OWNER.
6. THE CONTRACTOR SHALL CONTACT RESPECTIVE UTILITY COMPANIES PRIOR TO DEMOLITION TO COORDINATE DISCONNECTION AND REMOVAL OF EXISTING UTILITIES WITHIN THE AREA OF WORK.
7. THE CONTRACTOR SHALL BE SOLELY RESPONSIBLE FOR ANY DAMAGE TO EXISTING UTILITIES THAT ARE INTENDED TO CONTINUE TO PROVIDE SERVICE WHETHER THESE UTILITIES ARE SHOWN ON THE PLAN OR NOT.
8. UPON DISCOVERY OF ANY UNDERGROUND TANKS, CONTRACTOR SHALL IMMEDIATELY NOTIFY THE OWNER'S REPRESENTATIVE. NO REMOVAL OF TANKS SHALL OCCUR UNTIL AUTHORIZED BY OWNER.
9. BUILDING AND APPURTENANCES DESIGNATED FOR DEMOLITION SHALL NOT BE DISTURBED BY THE CONTRACTOR UNTIL HE HAS FURNISHED WITH NOTICE TO PROCEED BY THE OWNER. AS SOON AS SUCH NOTICE HAS BEEN GIVEN, THE CONTRACTOR SHALL PERFORM THE DEMOLITION, UNDER THE DIRECTION OF THE OWNER'S REPRESENTATIVE.


10. ALL EXISTING UTILITIES WITHIN THE EXISTING BUILDING ARE TO BE REMOVED WHERE CONFLICTS OCCUR WITH GRADE, BEAMS, PILES, PROPOSED UTILITIES AND TRENCH BACKFILLED AND COMPACTED IN ACCORDANCE WITH THE SPECIFICATIONS AND GEOTECHNICAL REPORT.
11. FOUNDATIONS, FLOORS, FLOOR SLABS, AND ANY OTHER UNDERGROUND BUILDING STRUCTURES SHALL BE REMOVED IN ACCORDANCE WITH THE SPECIFICATIONS. AREAS OF STRUCTURE REMOVAL SHALL BE BACKFILLED IN ACCORDANCE WITH SPECIFICATIONS AND THE GEOTECHNICAL REPORT.
12. DEBRIS SHALL NOT BE BURIED ON THE SUBJECT SITE. ALL UNSUITABLE MATERIAL AND DEBRIS SHALL BE REMOVED FROM THE SITE AND DISPOSED OF IN ACCORDANCE WITH ALL CITY, STATE, AND FEDERAL LAWS AND ORDINANCES.
13. ALL MATERIAL, EXCEPT THAT BELONGING TO A PUBLIC UTILITY COMPANY OR DENOTED FOR SALVAGE, SHALL BECOME PROPERTY OF THE CONTRACTOR. THE CONTRACTOR SHALL NOTIFY THE OWNER OF WATER, ELECTRIC, OR GAS METERS WHEN THE METERS ARE READY FOR REMOVAL, AND THE CONTRACTOR SHALL BE RESPONSIBLE FOR DISCONNECTING ALL UTILITIES IN COMPLIANCE WITH LOCAL REQUIREMENTS. DISCONNECT TRANSFORMERS AS REQUIRED FOR BUILDING DEMOLITION.
14. AS SOON AS DEMOLITION WORK HAS BEEN COMPLETED, THE FINAL GRADE OF BACKFILL IN DEMOLITION AREAS SHALL BE COMPACTED PER THE GEOTECHNICAL REPORT TO PRESENT A NEAT, WELL DRAINED APPEARANCE, AND TO PREVENT WATER FROM DRAINING UNNECESSARILY ONTO ADJACENT PROPERTIES. CONTRACTOR SHALL GRADE SITE TO EXISTING STORM DRAINAGE SYSTEM TO REMAIN ON SITE.
15. EXISTING TREES TO REMAIN SHOULD BE PROTECTED FROM DAMAGE DURING DEMOLITION AND CONSTRUCTION.
16. THE CONTRACTOR IS TO COORDINATE WORK IN THIS PROJECT TO ENSURE ACCESS TO ADJACENT PROPERTIES AT ALL TIMES.
17. REMOVAL OF ANY EXISTING PAVEMENT SHALL BE TO THE NEAREST PAVEMENT JOINT (THE ENTIRE CONCRETE PANEL NEEDS TO BE REMOVED AND REPLACED).

1. ALL GRADING AND SITE PREPARATION SHALL CONFORM WITH SPECIFICATIONS CONTAINED IN THE GEOTECHNICAL REPORT.
2. ALL CONSTRUCTION MATERIALS AND WORKMANSHIP SHALL BE IN ACCORDANCE TO THE AUTHORITY HAVING JURISDICTION (AHJ) LATEST CONSTRUCTION SPECIFICATIONS AND DETAILS.
3. PRIOR TO ANY EXCAVATION OF THE PROJECT SITE, THE CONTRACTOR SHALL NOTIFY THE (AHJ) 48 HOURS PRIOR TO THE START OF CONSTRUCTION.
4. THE CONTRACTOR SHALL CAREFULLY PRESERVE BENCHMARKS, REFERENCE POINTS AND STAKES.
5. ALL INDICATED ELEVATIONS ARE FINISHED ELEVATIONS.
6. FIELD VERIFY LOCATIONS, SIZES AND IF APPLICABLE INVERTS OF EXISTING UTILITIES FOR PROPOSED CONNECTIONS PRIOR TO CONSTRUCTION.
7. LOCATE AND PROTECT ALL UTILITIES ASSOCIATED WITH THE PROJECT PRIOR TO CONSTRUCTION.
8. INSTALL SILT CONTROL MEASURES BEFORE BEGINNING SITE WORK. THESE MEASURES SHALL BE MAINTAINED THROUGHOUT CONSTRUCTION.
9. MAINTAIN PROPER SITE DRAINAGE AT ALL TIMES DURING CONSTRUCTION. PREVENT STORM WATER FROM RUNNING INTO OR STANDING IN EXCAVATED AREAS.
10. INSTALL ALL APPROPRIATE TREE PROTECTION MEASURES PRIOR TO GRADING.
11. CUT AND FILL SLOPES SHALL HAVE A MAXIMUM SLOPE OF 3:1.

2. ALL EXCAVATION SHALL INCLUDE CLEARING, STRIPPING AND STOCKPILING TOPSOIL REMOVING UNSUITABLE MATERIALS, THE CONSTRUCTION OF EMBANKMENTS CONSTRUCTION FILLS, AND THE FINAL SHAPING AND TRIMMING TO THE THE LINES AND GRADES SHOWN ON THE PLANS.
13. ALL TREES, BRUSH, AND ORGANIC TOPSOIL AND OTHER OBJECTIONABLE MATERIAL SHALL BE REMOVED, UNLESS OTHERWISE SPECIFIED, AND DISPOSED OF AT AN OFF-SITE LOCATION WITH THE EXCEPTION THAT ENOUGH TOPSOIL SHALL BE RETAINED FOR RESPEAD AND GENERAL LANDSCAPING. AREAS WHICH ARE TO BE FILLED SHALL CONFORM WITH SPECIFICATIONS CONTAINED IN GEOTECHNICAL REPORT.
14. STRIP AND STOCKPILE TOPSOIL. SPREAD FOUR (4) INCHES MINIMUM OF TOPSOIL ON LANDSCAPE AREAS AND REMOVE EXCESS TOPSOIL FROM SITE. PREPARE SUB-GRADE FOR PAVEMENT AND CURBS AND BACKFILL CURBS AFTER CURB CONSTRUCTION.
15. PROVIDE SUPPLY OF TOPSOIL FOR LANDSCAPE CONTRACTOR FOR INSTALLATION IN ALL LANDSCAPE ISLANDS.
16. PROVIDE AND INSTALL TOPSOIL IN DISTURBED AREAS TO BE GRASSED, TO INCLUDE PAVEMENT SHOULDERS AND DETENTION AREAS (IF ANY).
17. ALL EARTHWORK AND BASE COURSE FOR THE PARKING AREA CONFORM WITH SPECIFICATIONS CONTAINED IN GEOTECHNICAL REPORT.
18. THE PAVEMENT SUBGRADE AND BASE COURSE MATERIAL SHALL BE INSPECTED AND APPROVED BY THE ENGINEER OR OWNER REPRESENTATIVE PRIOR TO CONSTRUCTING THE BASE AND SURFACE COURSES THEREON.
19. CONTRACTOR SHALL PROVIDE POSITIVE DRAINAGE TO ALL INLETS AND CATCH BASINS. AREAS OF SURFACE PONDING SHALL BE CORRECTED BY CONTRACTOR AT NO ADDITIONAL EXPENSE TO THE OWNER.
20. IF AREAS ARE DISTURBED BEYOND PROPOSED GRADES BY NEGLIGENCE OF THE CONTRACTOR, THE CONTRACTOR SHALL BE HELD RESPONSIBLE FOR ANY REGRADEING OR REPAIR TO MATCH ORIGINAL EXISTING CONDITIONS.
21. SHORING SHALL BE DONE AS NECESSARY FOR THE PROTECTION OF THE WORK AND FOR THE SAFETY OF PERSONNEL. SHORING SHALL BE IN ACCORDANCE WITH ALL O.S.H.A AND (AHJ) REGULATIONS.

22. STRUCTURES FOR STORM SEWERS SHALL BE IN ACCORDANCE WITH THESE IMPROVEMENT PLANS AND THE APPLICABLE STANDARD SPECIFICATIONS. WHERE GRANULAR TRENCH BACKFILL IS REQUIRED AROUND THESE STRUCTURES, THE COST SHALL BE CONSIDERED AS INCIDENTAL AND SHALL BE INCLUDED IN THE CONTRACT UNIT PRICE FOR THE STRUCTURE.
23. CONFIRM INVERTS OF ALL EXISTING STORM INLETS AND SANITARY SEWER MANHOLES BEFORE COMMENCING CONSTRUCTION.
24. ALL STORM SEWER LINES 18"-54" DIAMETER ARE TO BE REINFORCED CONCRETE PIPE ACCORDING TO ASTM C-76 TYPE III, UNLESS OTHERWISE SPECIFIED ON PLANS.
25. A GEOTEXTILE MATTING (LANDLOCK TRM 450 OR EQUIVALENT) SHALL BE USED FOR EROSION CONTROL ON ALL SLOPES GREATER THAN 3H:1V.
26. DRAINAGE STRUCTURES AND DETENTION POND SHALL BE MAINTAINED BY PROPERTY OWNERS.
26. CONTRACTOR SHALL ADHERE TO PROPOSED GRADES ALONG CREEKS, ESPECIALLY IN THE AREA OF THE PROPOSED DETENTION POND. IF AREAS ARE DISTURBED BEYOND PROPOSED GRADES BY NEGLIGENCE OF THE CONTRACTOR, THE CONTRACTOR SHALL BE HELD RESPONSIBLE FOR ANY PENALTIES INCURRED.
27. ALL PROPOSED SPOT ELEVATIONS SHOWN INDICATE FINISHED GRADED ELEVATIONS AT EDGE OF PAVEMENT AND/OR GRADE BREAKS, UNLESS OTHERWISE NOTED.

1. CONTRACTOR IS TO VERIFY THE LOCATION OF ALL EXISTING UTILITIES PRIOR TO CONSTRUCTION AND ENSURE NO CONFLICTS EXIST WITH PROPOSED IMPROVEMENTS. NOTIFY ENGINEER IMMEDIATELY IF UTILITIES ARE LOCATED DIFFERENTLY THAN SHOWN. THE CONTRACTOR SHALL COORDINATE WITH EACH RESPECTIVE UTILITY COMPANY IN ORDER TO RELOCATE IF NEEDED IN CONFORMANCE WITH THEIR GUIDELINES.
2. CONTRACTOR SHALL NOTIFY AND COORDINATE WITH THE APPROPRIATE UTILITY COMPANY PRIOR TO THE REMOVAL OF INDICATED UTILITIES ON SITE (SEE DEMOLITION PLAN). CONTRACTOR SHALL BE RESPONSIBLE FOR OBTAINING ANY PERMITS REQUIRED FOR DEMOLITION AND HAUL OFF FROM THE APPROPRIATE AUTHORITIES.
3. AUTHORIZATION MUST BE OBTAINED FROM THE AUTHORITY HAVING JURISDICTION (AHJ) WATER SYSTEM TO CONSTRUCT, ALTER OR MODIFY A WATER OR SEWER LINE. CONSTRUCTION OF WATER AND SEWER INFRASTRUCTURE WILL BE AUTHORIZED BY THE WATER SYSTEM UPON:
  - APPROVAL OF SUBMITTED PLANS.
  - NOTIFICATION OF THE WATER SYSTEM AT LEAST 24 HOURS PRIOR TO STARTING CONSTRUCTION.
4. AT THE COMPLETION OF THE WATER AND/OR SEWER CONSTRUCTION AND PRIOR TO RECORDING THE FINAL PLAT, THE CONTRACTOR WILL FURNISH THE WATER SYSTEM INSPECTOR RECORD DRAWINGS OF THE PROJECT.
5. BUILDING CONTRACTOR SHALL BE RESPONSIBLE FOR COORDINATION WITH THE GAS COMPANY FOR THE CONSTRUCTION OF THE GAS LINE BETWEEN METER AND MAIN.
6. BUILDING CONTRACTOR SHALL BE RESPONSIBLE FOR COORDINATION WITH THE POWER COMPANY FOR THE CONSTRUCTION OF ELECTRICAL CONDUIT TO PROVIDE SERVICE TO THE TRANSFORMER.
7. THE CONTRACTOR SHALL BE RESPONSIBLE FOR VERIFYING, PRIOR TO CONSTRUCTION, ALL EXISTING LOCATIONS AND INVERT ELEVATIONS OF SANITARY SEWERS, STORM DRAINAGE, AND WATER MAINS. IF ANY INVERT ELEVATION VARIES MORE THAN 0.1 FT. FROM RECORD ELEVATIONS, THE CONTRACTOR SHALL NOTIFY THE ENGINEER IMMEDIATELY. WORK SHALL NOT PROCEED UNTIL THE CONTRACTOR IS NOTIFIED BY THE ENGINEER.
8. CONNECT TO EXISTING UTILITIES AND INSTALL UTILITIES IN COMPLIANCE WITH REQUIREMENTS OF APPROPRIATE JURISDICTIONAL AGENCIES.
9. COORDINATE WITH BUILDING PLANS TO ASSURE ACCURACY OF UTILITY CONNECTIONS AND COMPLIANCE WITH LOCAL CODES.
10. ALL SEWERS TO BE MAINTAINED THROUGHOUT CONSTRUCTION, INCLUDING CLEANING OF ANY SILT OR DEBRIS ACCUMULATED IN STRUCTURES.
11. ALL SURPLUS EXCAVATED MATERIAL FROM THE TRENCH SHALL BE DISPOSED OFF THE SITE BY CONTRACTOR.
12. COORDINATE EXACT TRENCHING, ROUTING, AND POINT OF TERMINATION WITH ALL UTILITY COMPANIES.

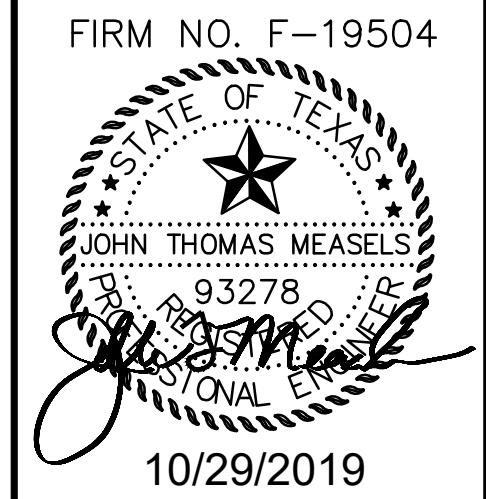

LOT 90, BLOCK A, VAN BUREN ESTATES  
NORTHWEST CORNER OF F.M.543 (WESTON ROAD)  
AND C.R.170 WESTON, TX 75097

NAME	DESCRIPTION	DATE	REV	PROJECT NO.
TWA	AS BUILT	10/29/19		IM-RR B001.0
				DRAWN BY:
				TWA
				CHECKED BY:
				AS
				ISSUE DATE:
				10/29/19

AS BUILT  
10/29/2019

THIS RECORD DRAWING IS A COMPILATION OF SEALED ENGINEERING  
DRAWINGS FOR THIS PROJECT MODIFIED BY INFORMATION FURNISHED  
BY THE CONTRACTOR, BASED ON THE CONTRACTORS' INFORMATION  
AND GENERAL INSPECTION BY THE CITY.

## C6.0

## GENERAL NOTES



J:\PRESIDENTIAL LAND\WESTON, TX - 170 & 543\CURRENT DRAWINGS LOT 90\DETAILS LOT 90.DWG 10/29/2019 6:02 PM TIM ANDRIES

CITY OF WESTON  
ENGINEERING DESIGN MANUAL  
APPENDIX B  
GENERAL NOTES

GENERAL

- All construction shall be in accordance with the North Central Texas Council of Governments Standard Specifications for Public Works Construction".
- Before beginning construction, the contractor shall prepare a construction sequence schedule. The construction sequence schedule shall be such that there is the minimum interference with traffic along or adjacent to the project.
- Construction may not begin earlier than 7:00 A.M. on weekdays nor continued after dark without permission from the City of Weston. Construction on Saturday may not begin before 8:00 A.M. and work on Sunday is prohibited without special permission.
- The contractor is responsible for verifying the location of all underground utilities and structures and protecting them from damage during construction.
- Work may not be backfilled or covered until it has been inspected by the City.
- Material testing shall be performed by an independent testing laboratory and paid for by the Contractor.
- All excavation on the project is unclassified.
- Temporary erosion control shall be used to minimize the spread of silt and mud from the project on to existing streets, alleys, drainage ways and public and private property. Temporary erosion controls may include straw bales, berms, dikes, swales, strips of undisturbed vegetation, check dams and other methods as required by the City of Weston.
- Finished Slopes on public rights-of-way and easements shall not be steeper than 4:1. All slopes steeper than 6:1 shall be hydro mulched and maintained by the contractor until grass covers all parts of the slope.
- The contractor shall maintain two-way traffic at all times along the project..
- Remove, salvage and replace all street and traffic control signs which may be damaged by the construction of the project.
- All trenching and excavation shall be performed in accordance with OSHA standards.

PAVING

- All embankment shall be com % Standard Proctor Density.
- All streets and alleys shall be piaceu on iime stabilized subgrade with a lime content of not less than 6%.
- The minimum 28 day compressive strength of concrete street paving shall not be less than 3600 PSI and shall be air entrained. Water may not be applied to the surface of concrete paving to improve workability.
- All curb and gutter shall be integral with the pavement.
- All street pavement must be cross-sloped or constructed on a parabolic crown section.
- Streets and alleys shall be constructed with provisions for sidewalk ramps at all intersections.

DRAINAGE

- Storm sewer pipe shall be reinforced concrete, Class III unless otherwise noted.
- All structural concrete shall be Class "C" (3600 PSI compressive strength at 28 days), air entrained.
- The Contractor shall install plugs in storm sewer lines or otherwise prevent mud from entering the storm sewer system during construction.


AS BUILT  
10/29/2019

THIS RECORD DRAWING IS A COMPILATION OF SEALED ENGINEERING  
DRAWINGS FOR THIS PROJECT MODIFIED BY INFORMATION FURNISHED  
BY THE CONTRACTOR, BASED ON THE CONTRACTORS' INFORMATION  
AND GENERAL INSPECTION BY THE CITY.



5900 S. Lake Forest Dr., Suite 380  
McKinney, TX 75070  
Ph. 214-491-1830  
John Measels, PE  
CIVIL ENGINEER  
FIRM NO. 19504

FIRM NO. F-19504

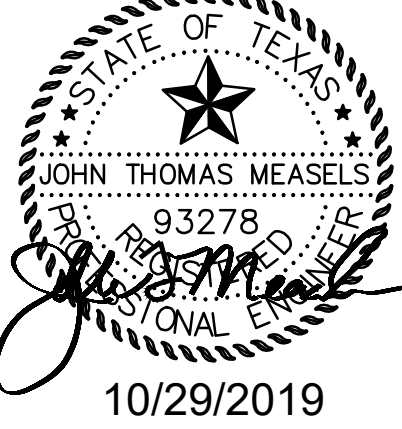

LOT 90, BLOCK A, VAN BUREN ESTATES  
NORTHWEST CORNER OF F.M.543 (WESTON ROAD)  
AND C.R.170 WESTON, TX 75097

PROJECT NO:	DATE	DESCRIPTION	NAME
JM-HRY001.0	10/29/19	AS BUILT	TWA
DRAWN BY:			
TWA			
CHECKED BY:			
AS			
ISSUE DATE:			
10/29/19			
CITY GENERAL NOTES			







C7.0







J:\PRESIDENTIAL LAND\WESTON, TX - 170 & 543\CURRENT DRAWINGS LOT 90.DWG 10/29/2019 6:02 PM T.M. ANDRIES

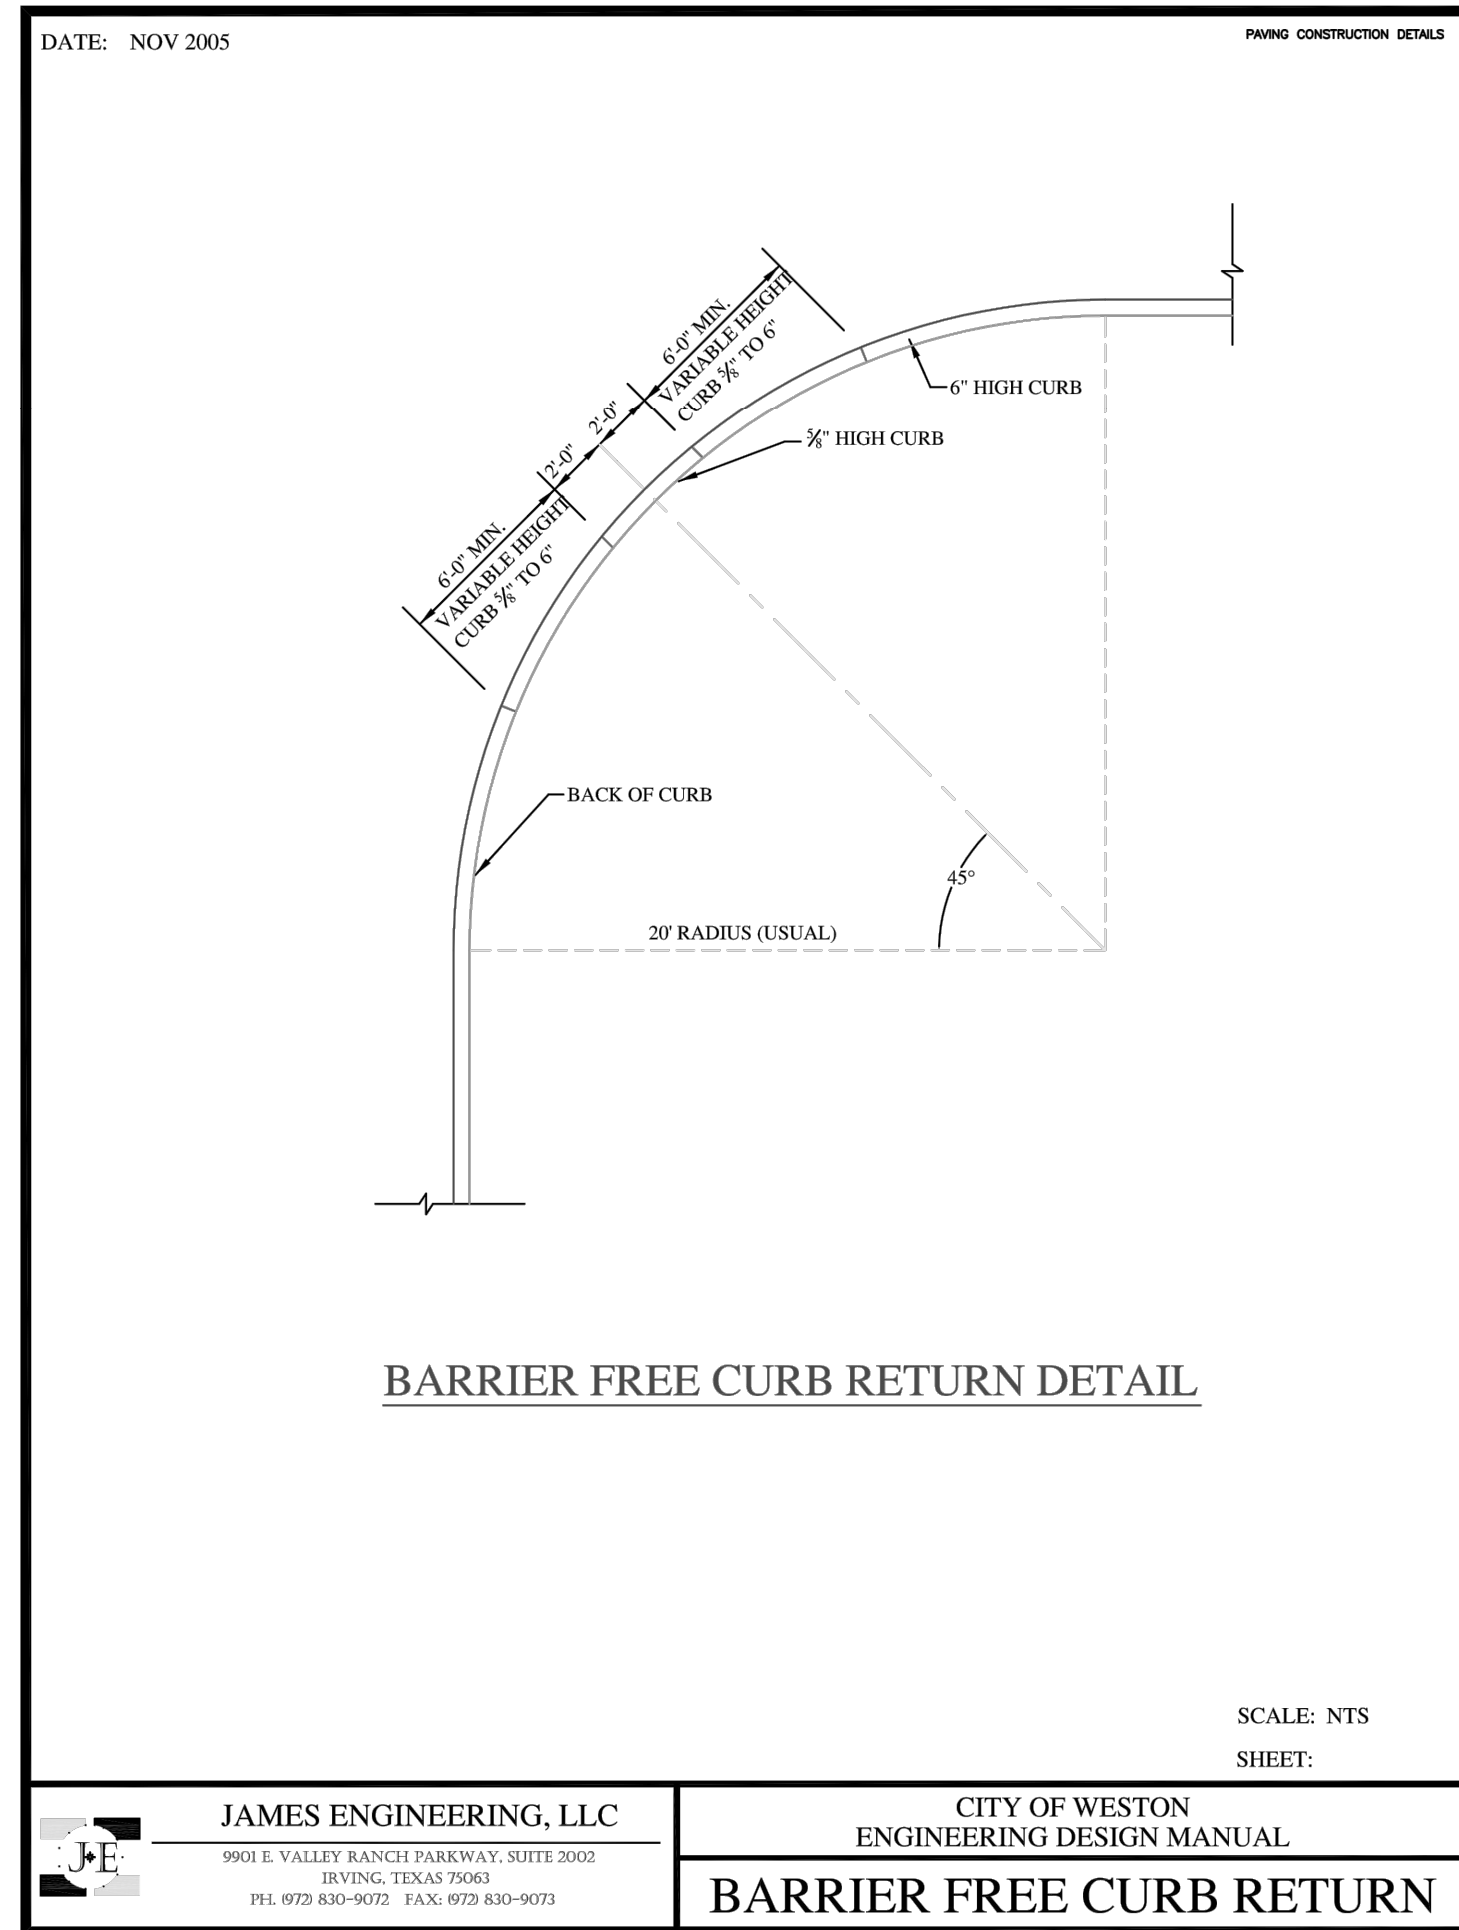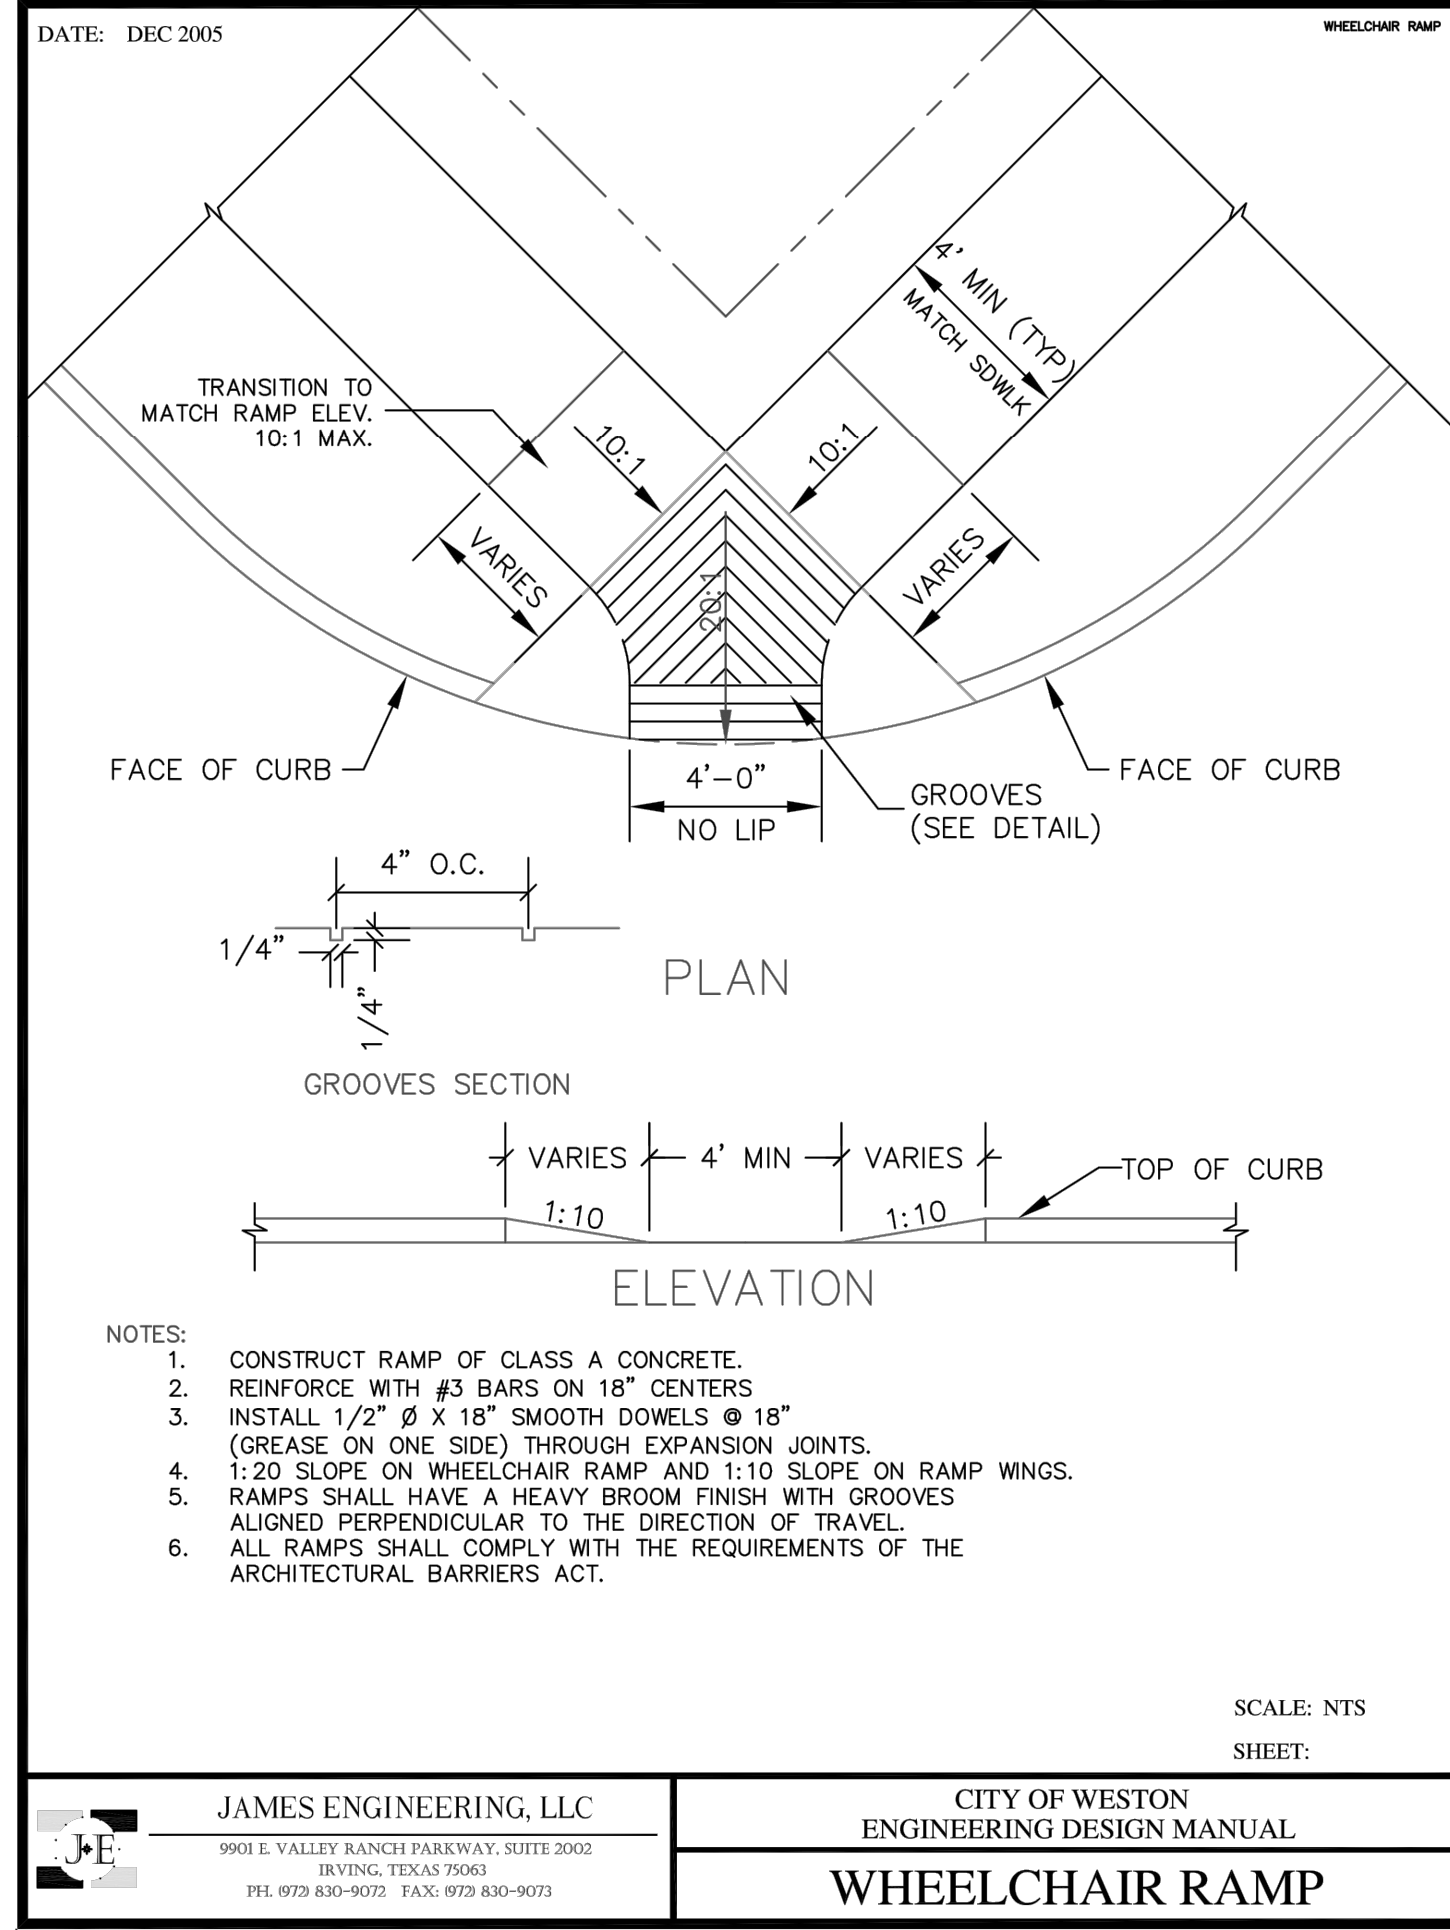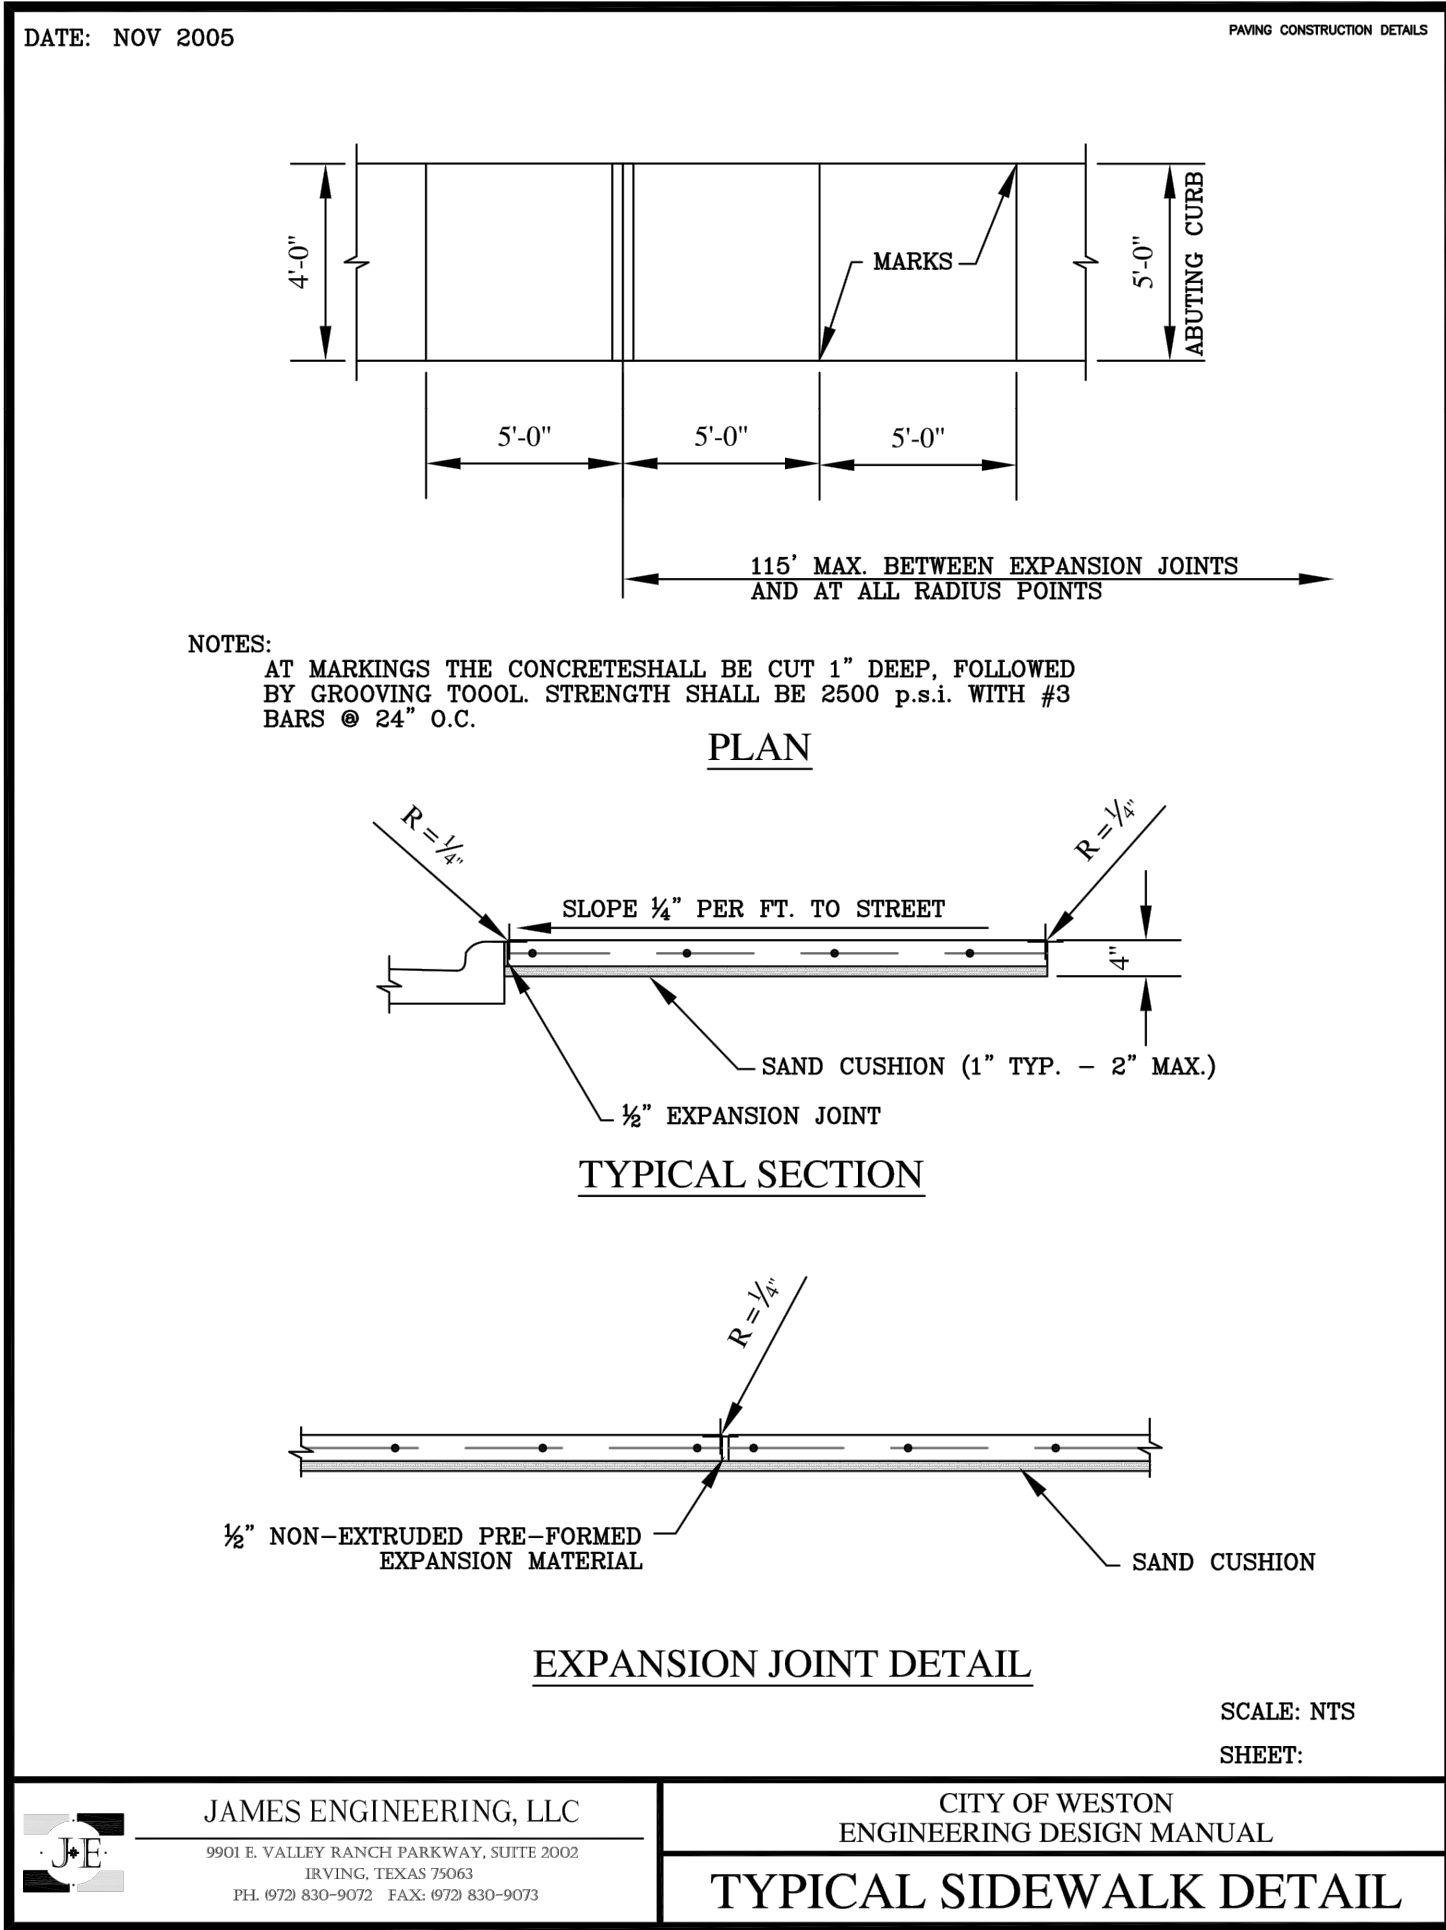
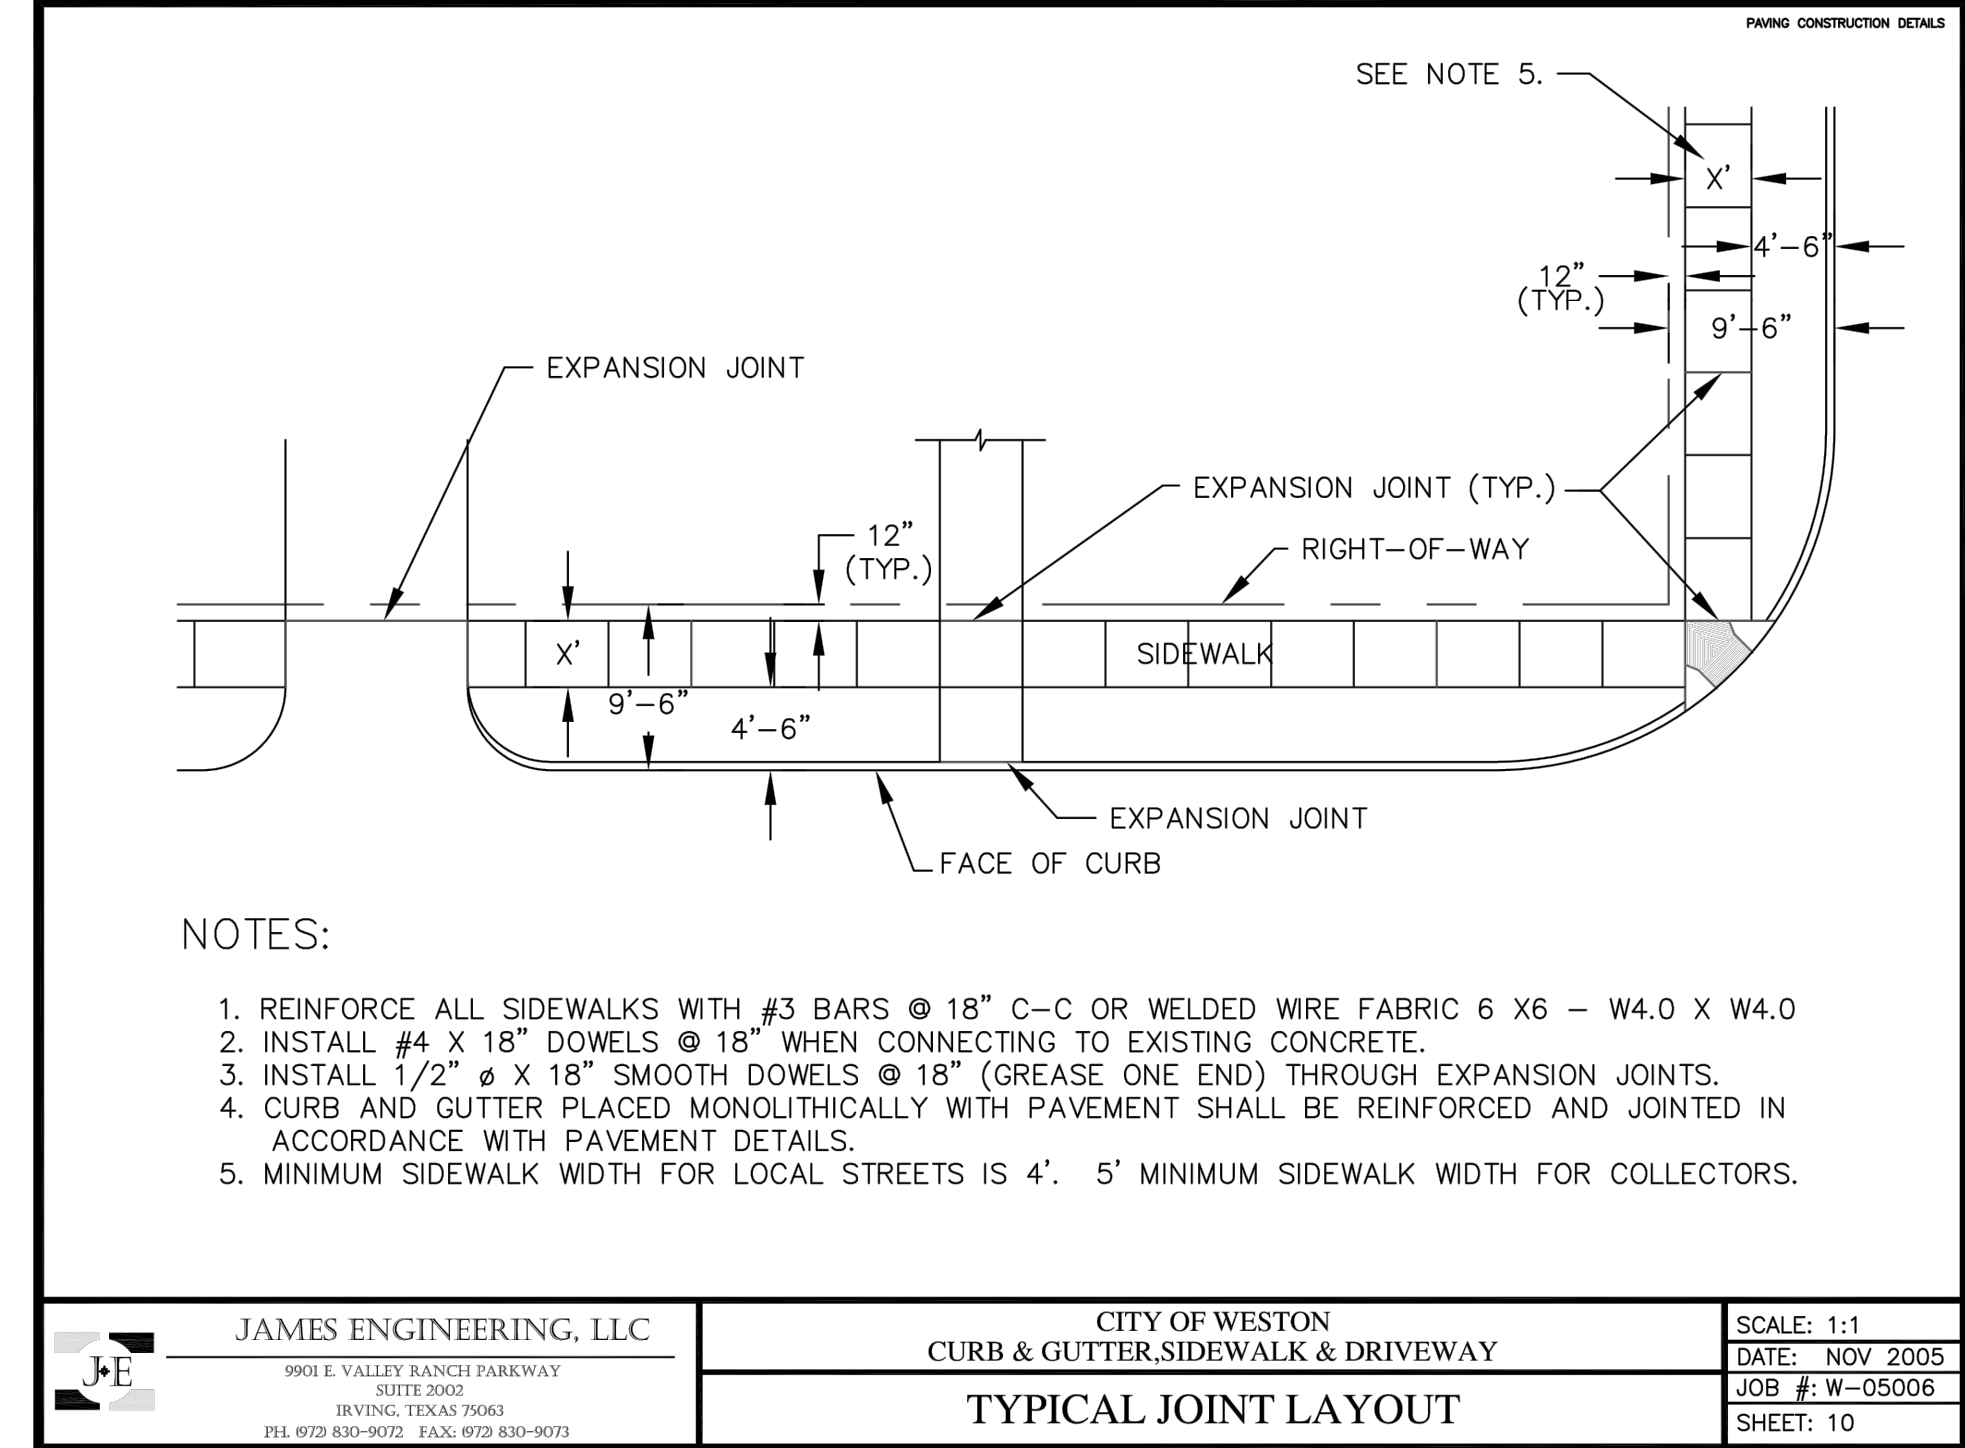
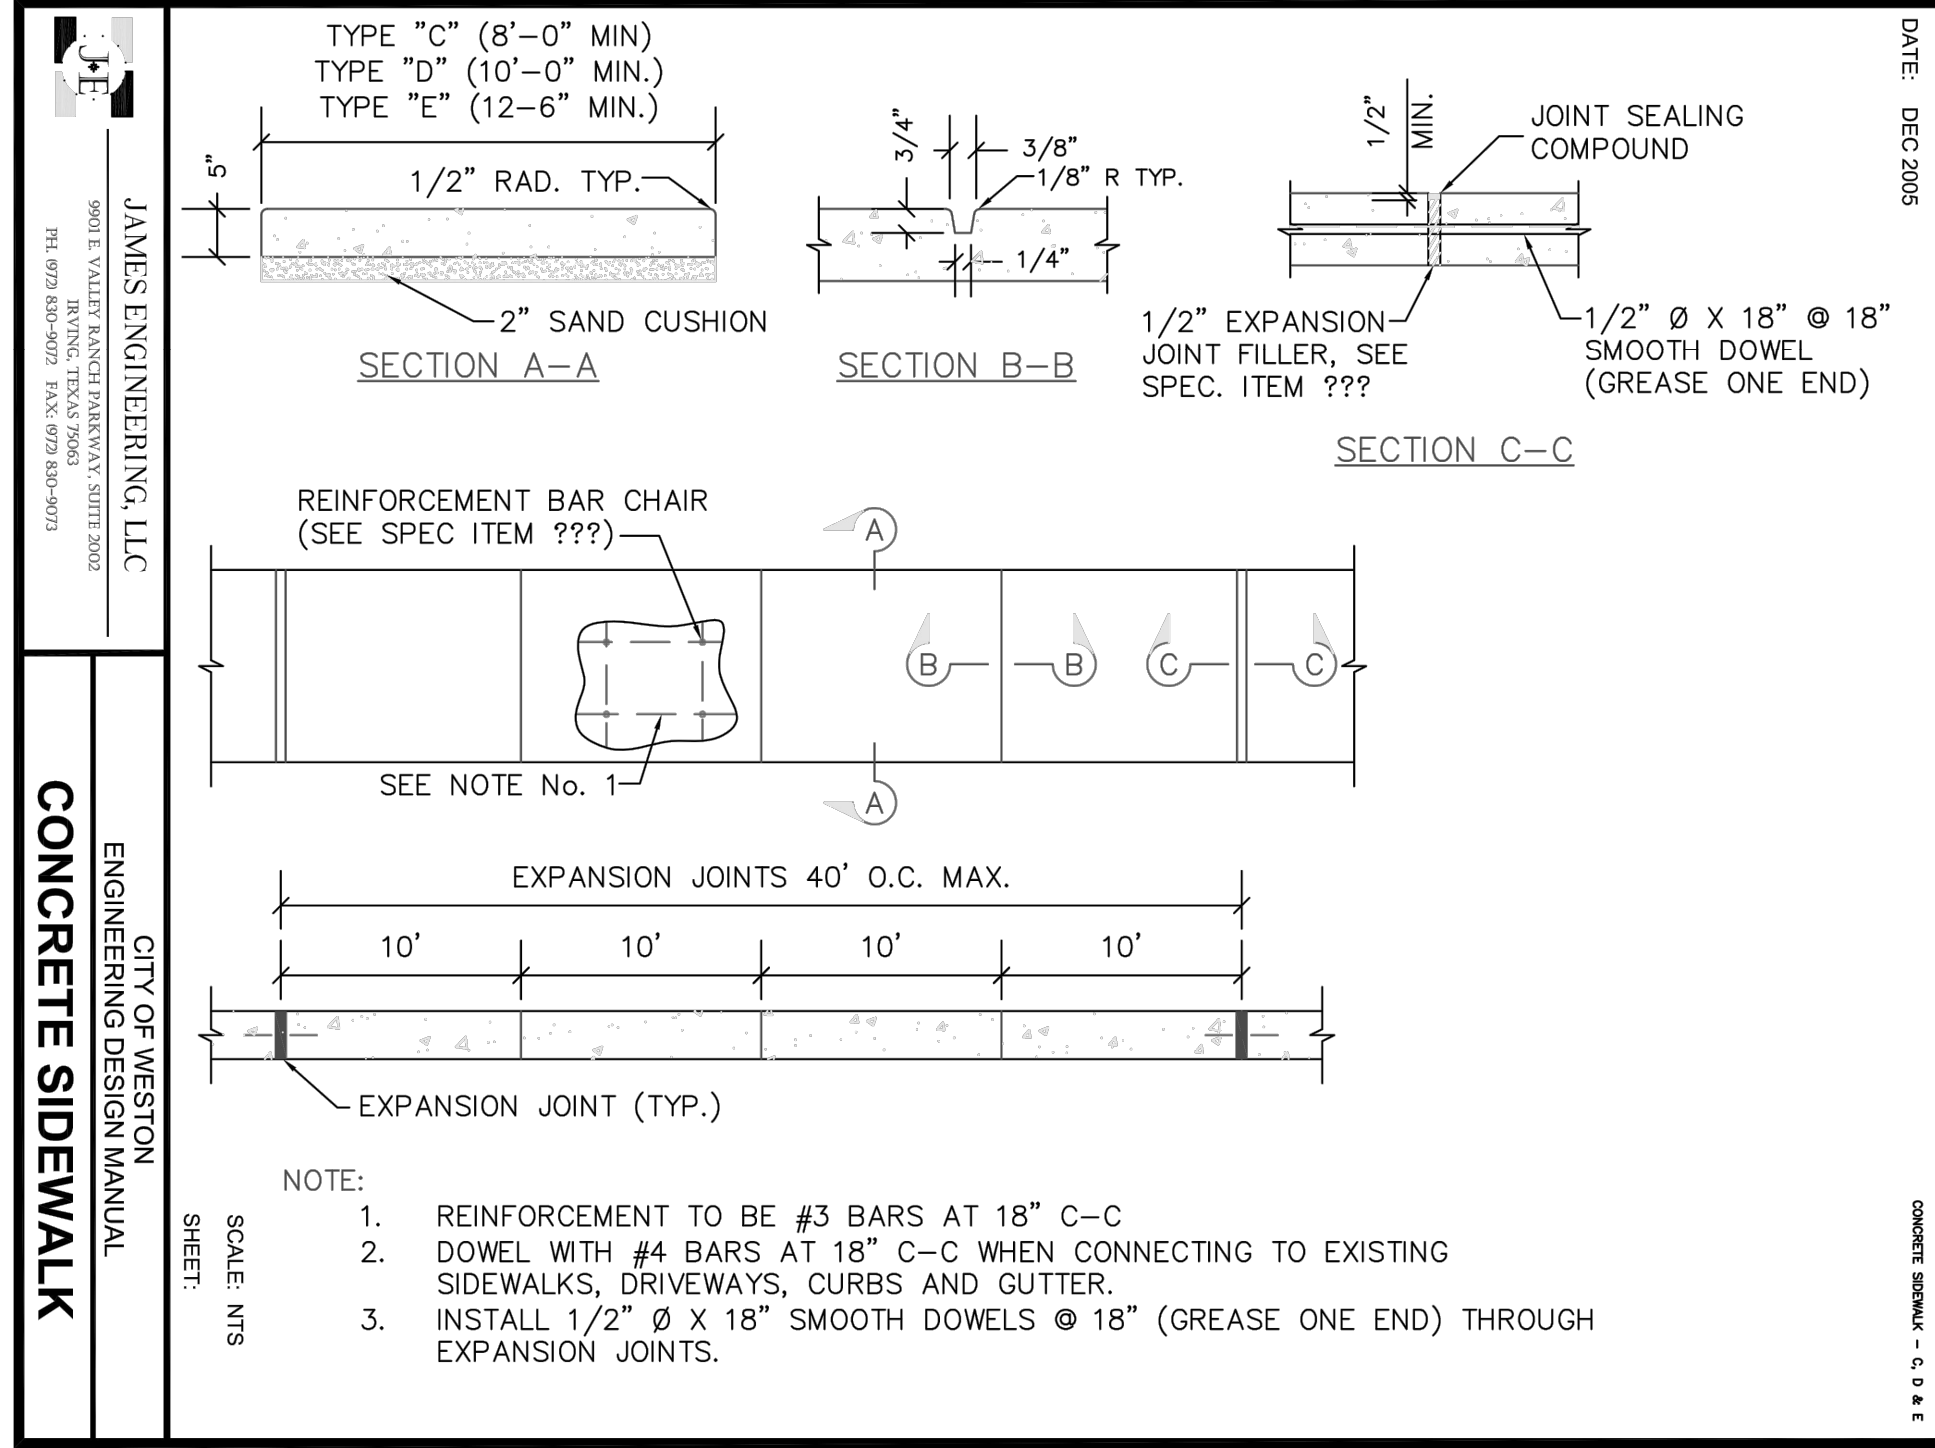
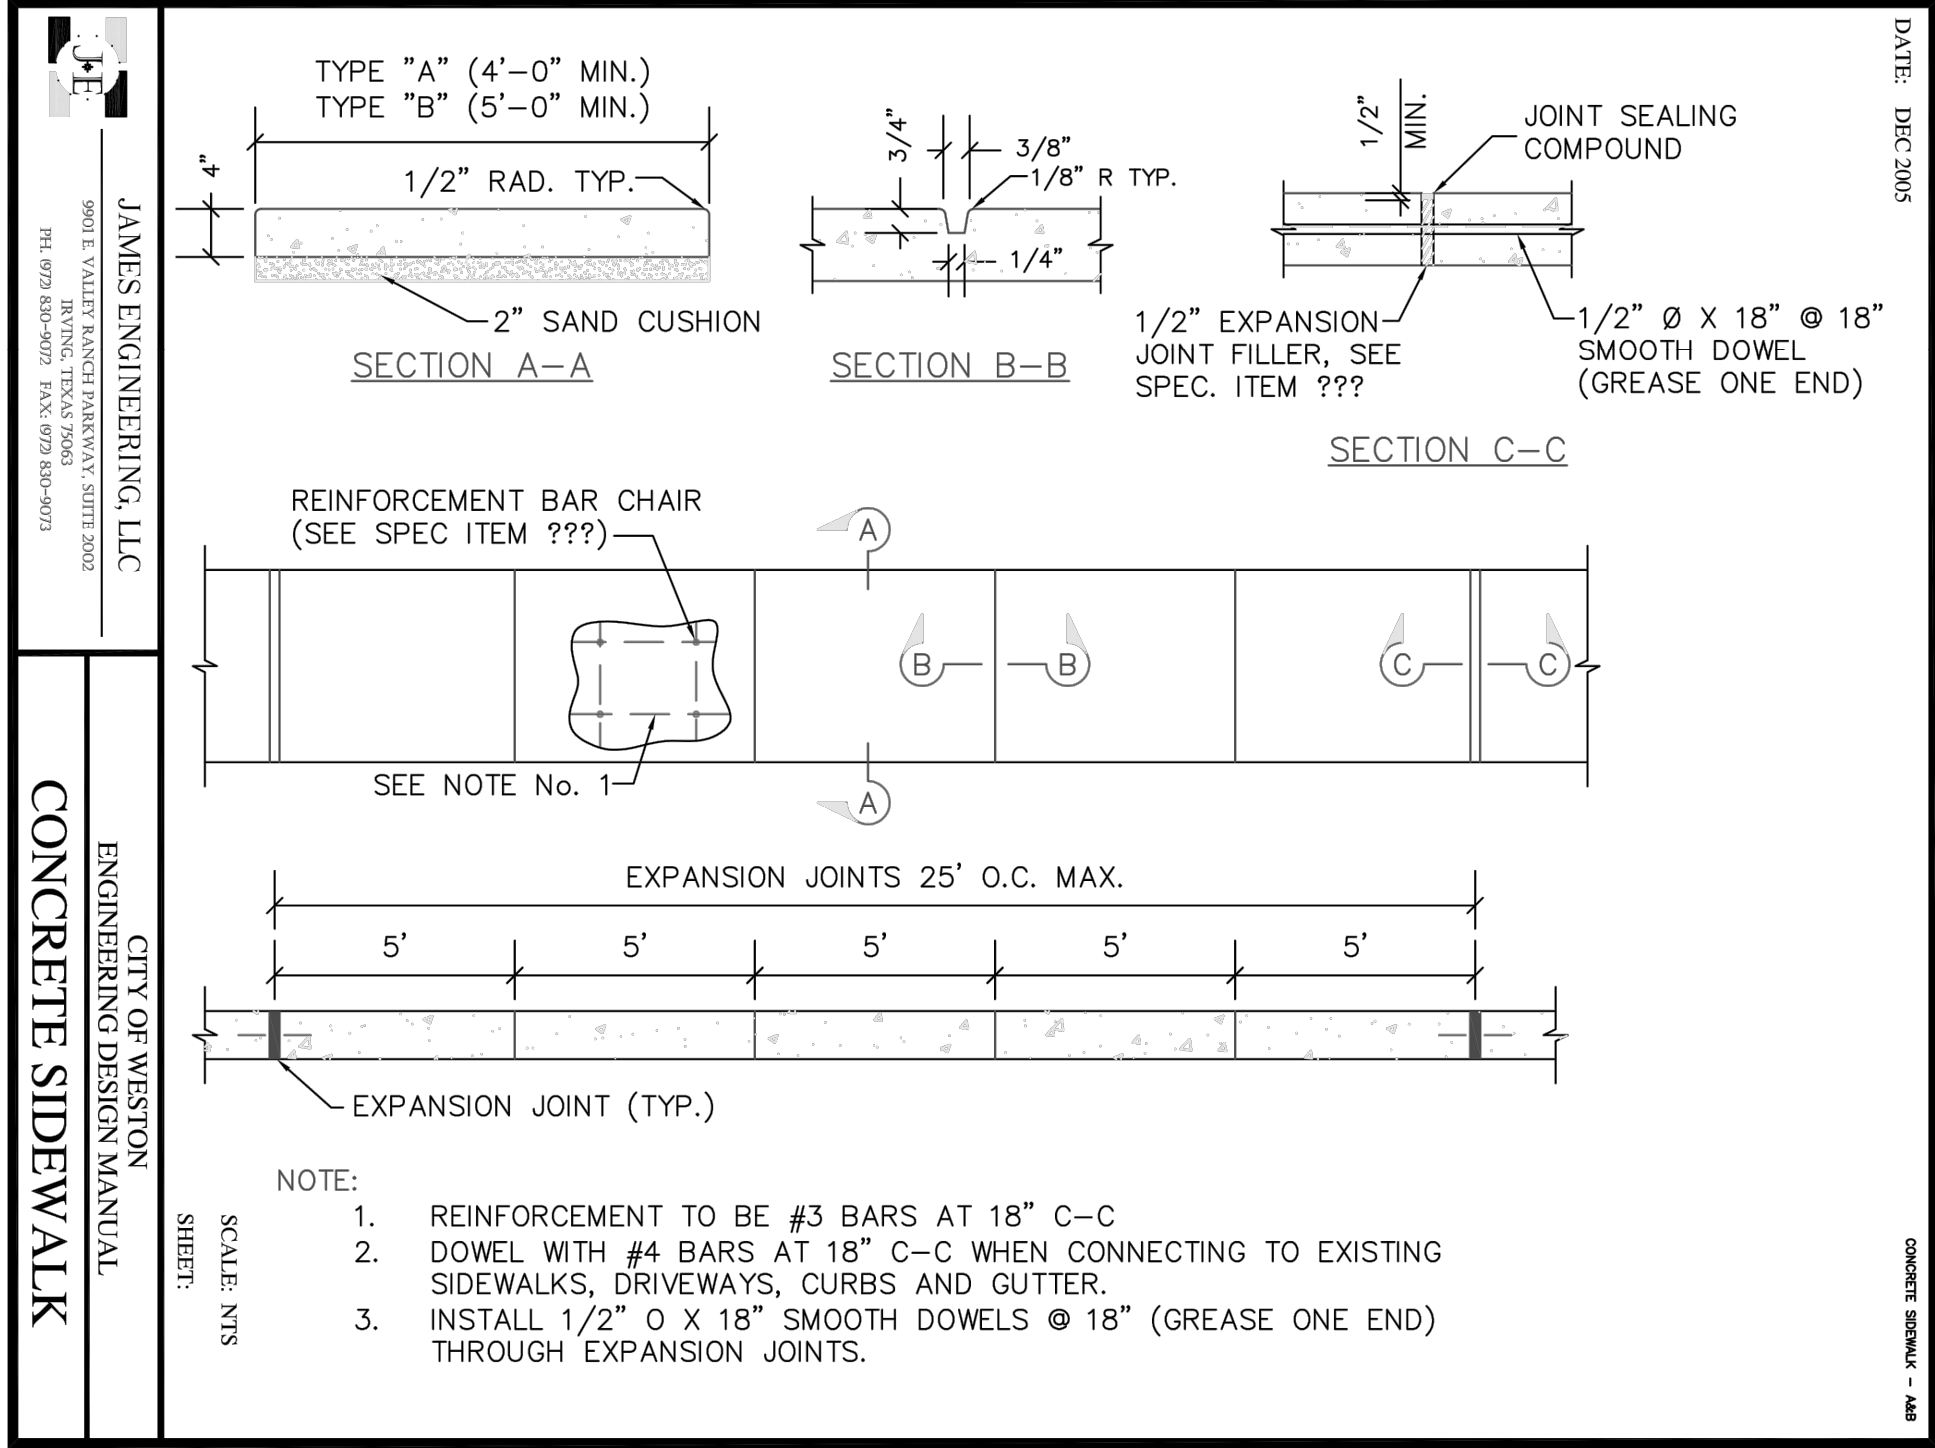


AS BUILT  
10/29/2019

THIS RECORD DRAWING IS A COMPILATION OF SEALED ENGINEERING DRAWINGS FOR THIS PROJECT MODIFIED BY INFORMATION FURNISHED BY THE CONTRACTOR, BASED ON THE CONTRACTORS' INFORMATION AND GENERAL INSPECTION BY THE CITY.

REV.	DATE	DESCRIPTION	NAME
1	10/29/19	AS BUILT	TWA
2			
3			
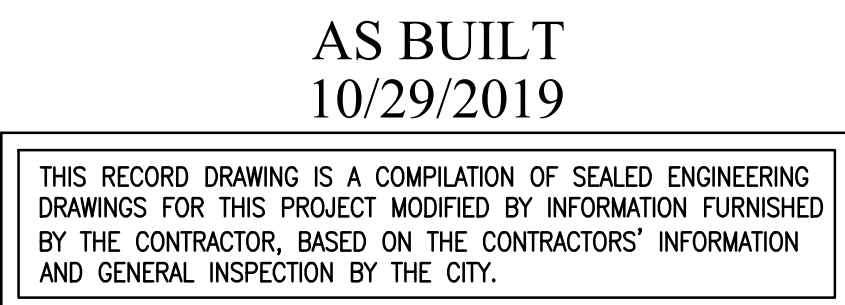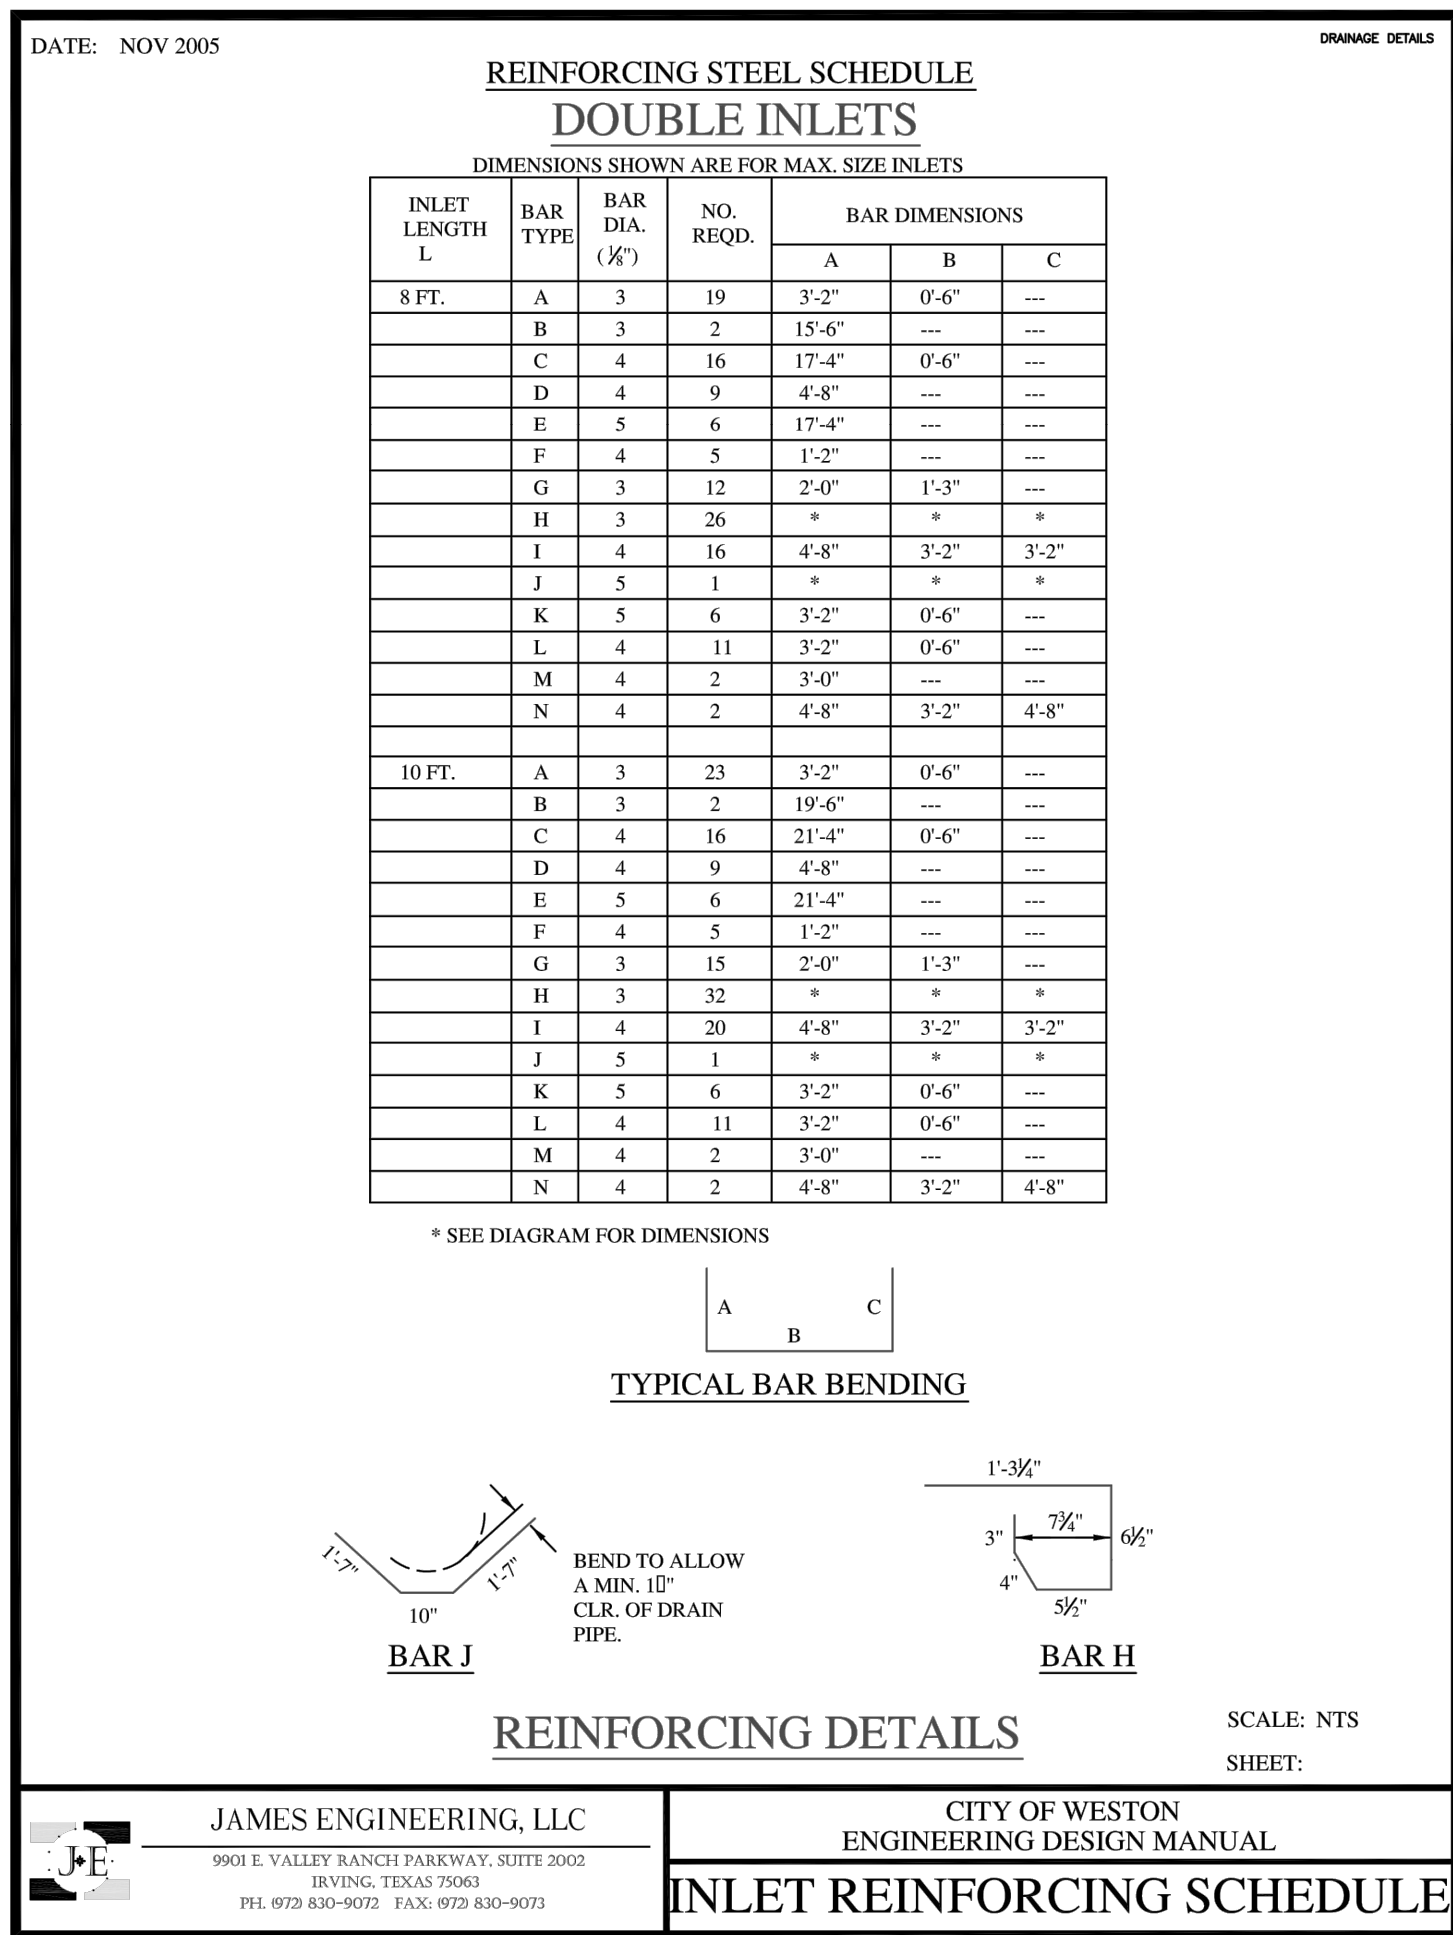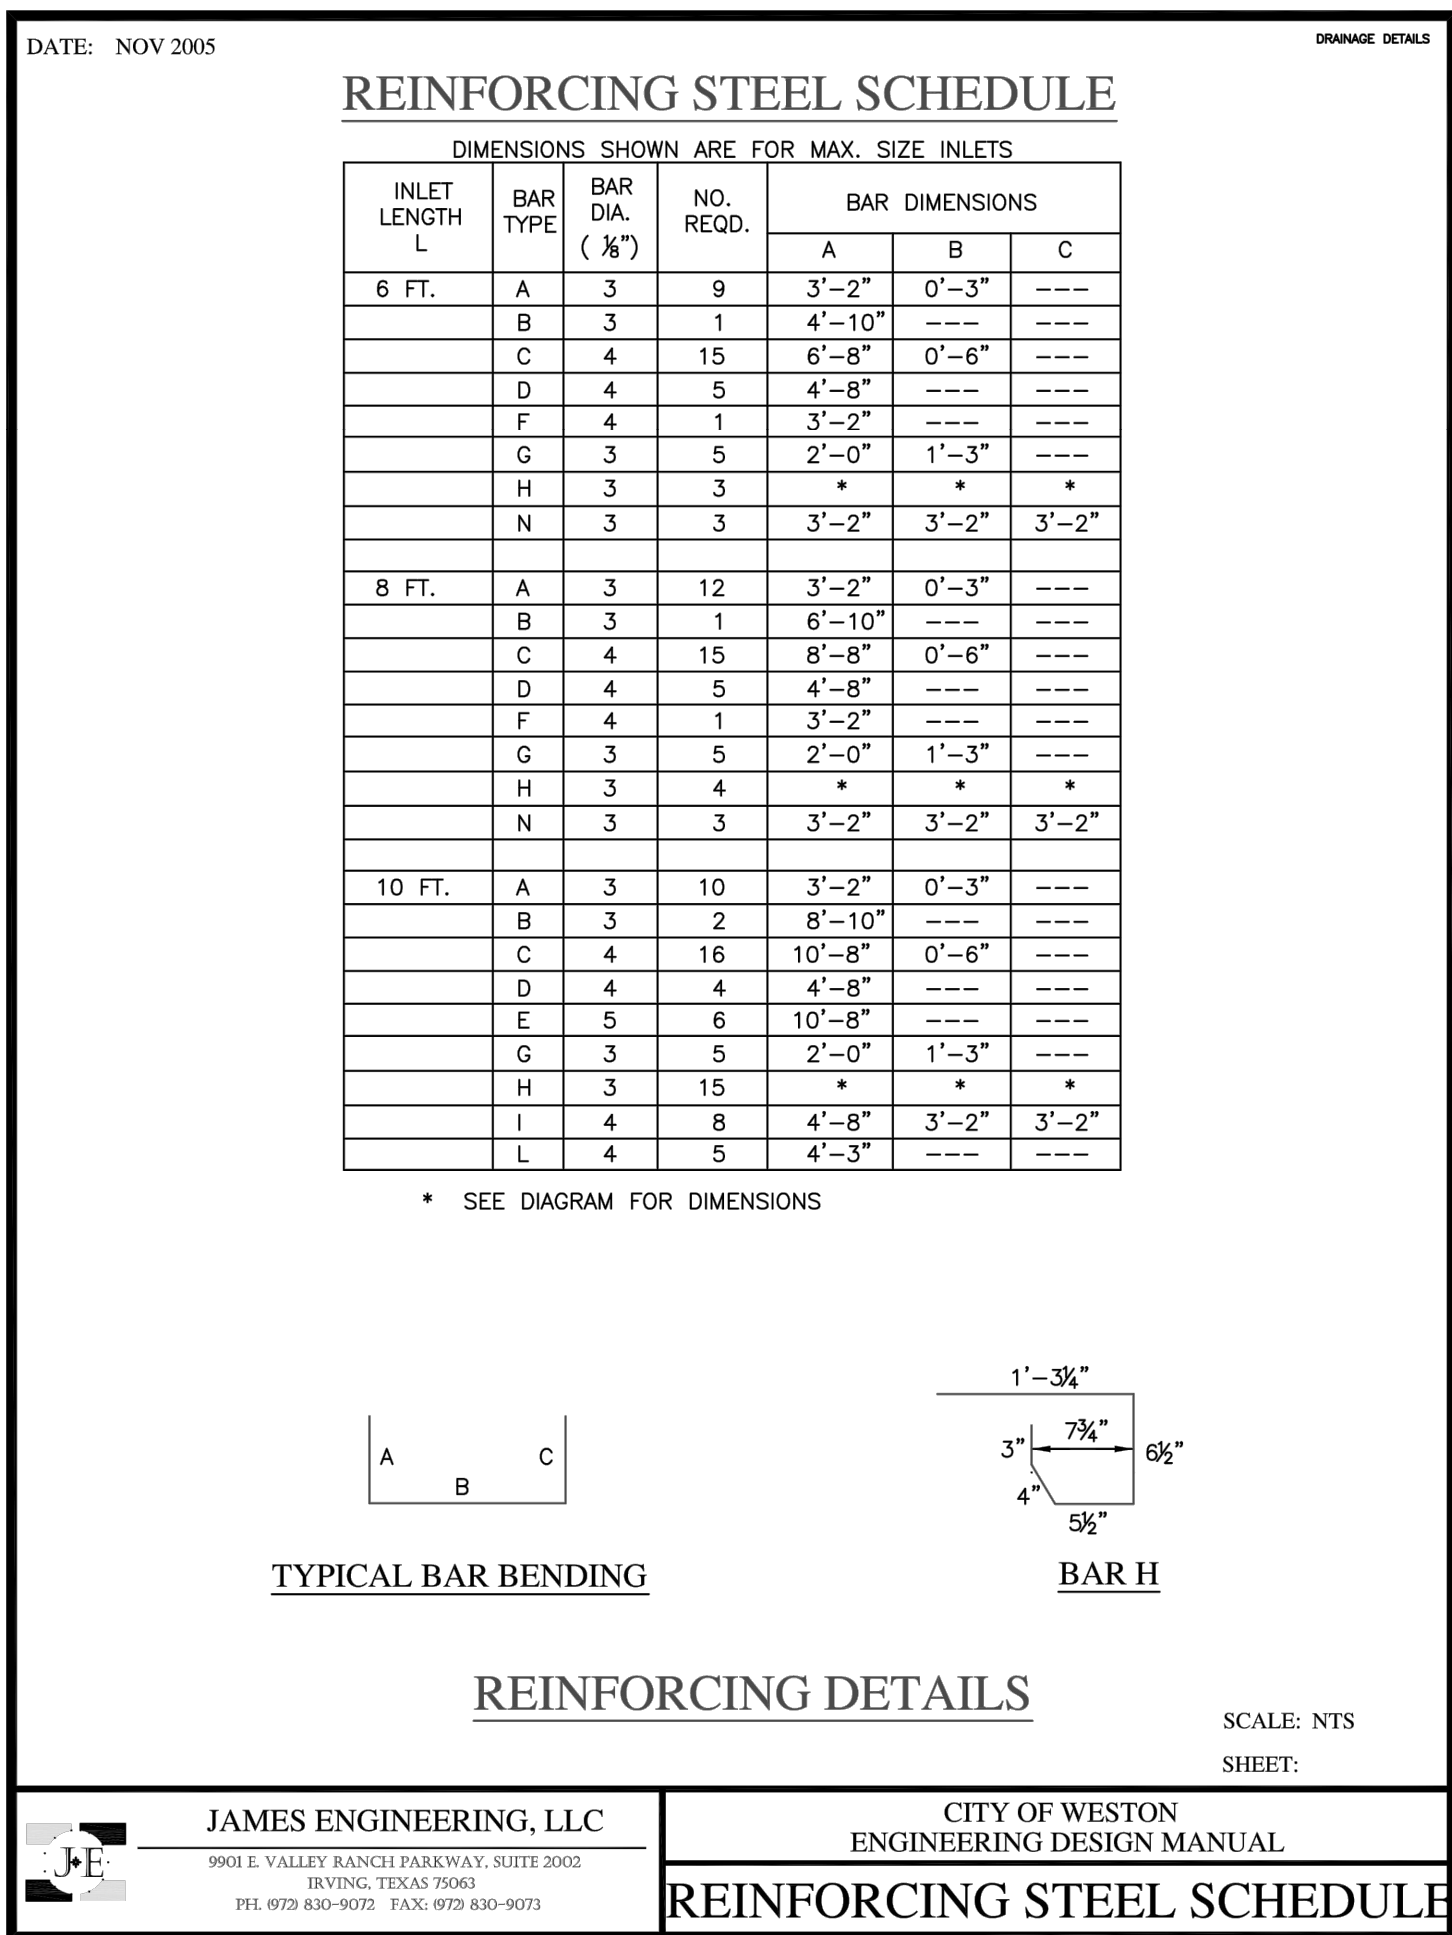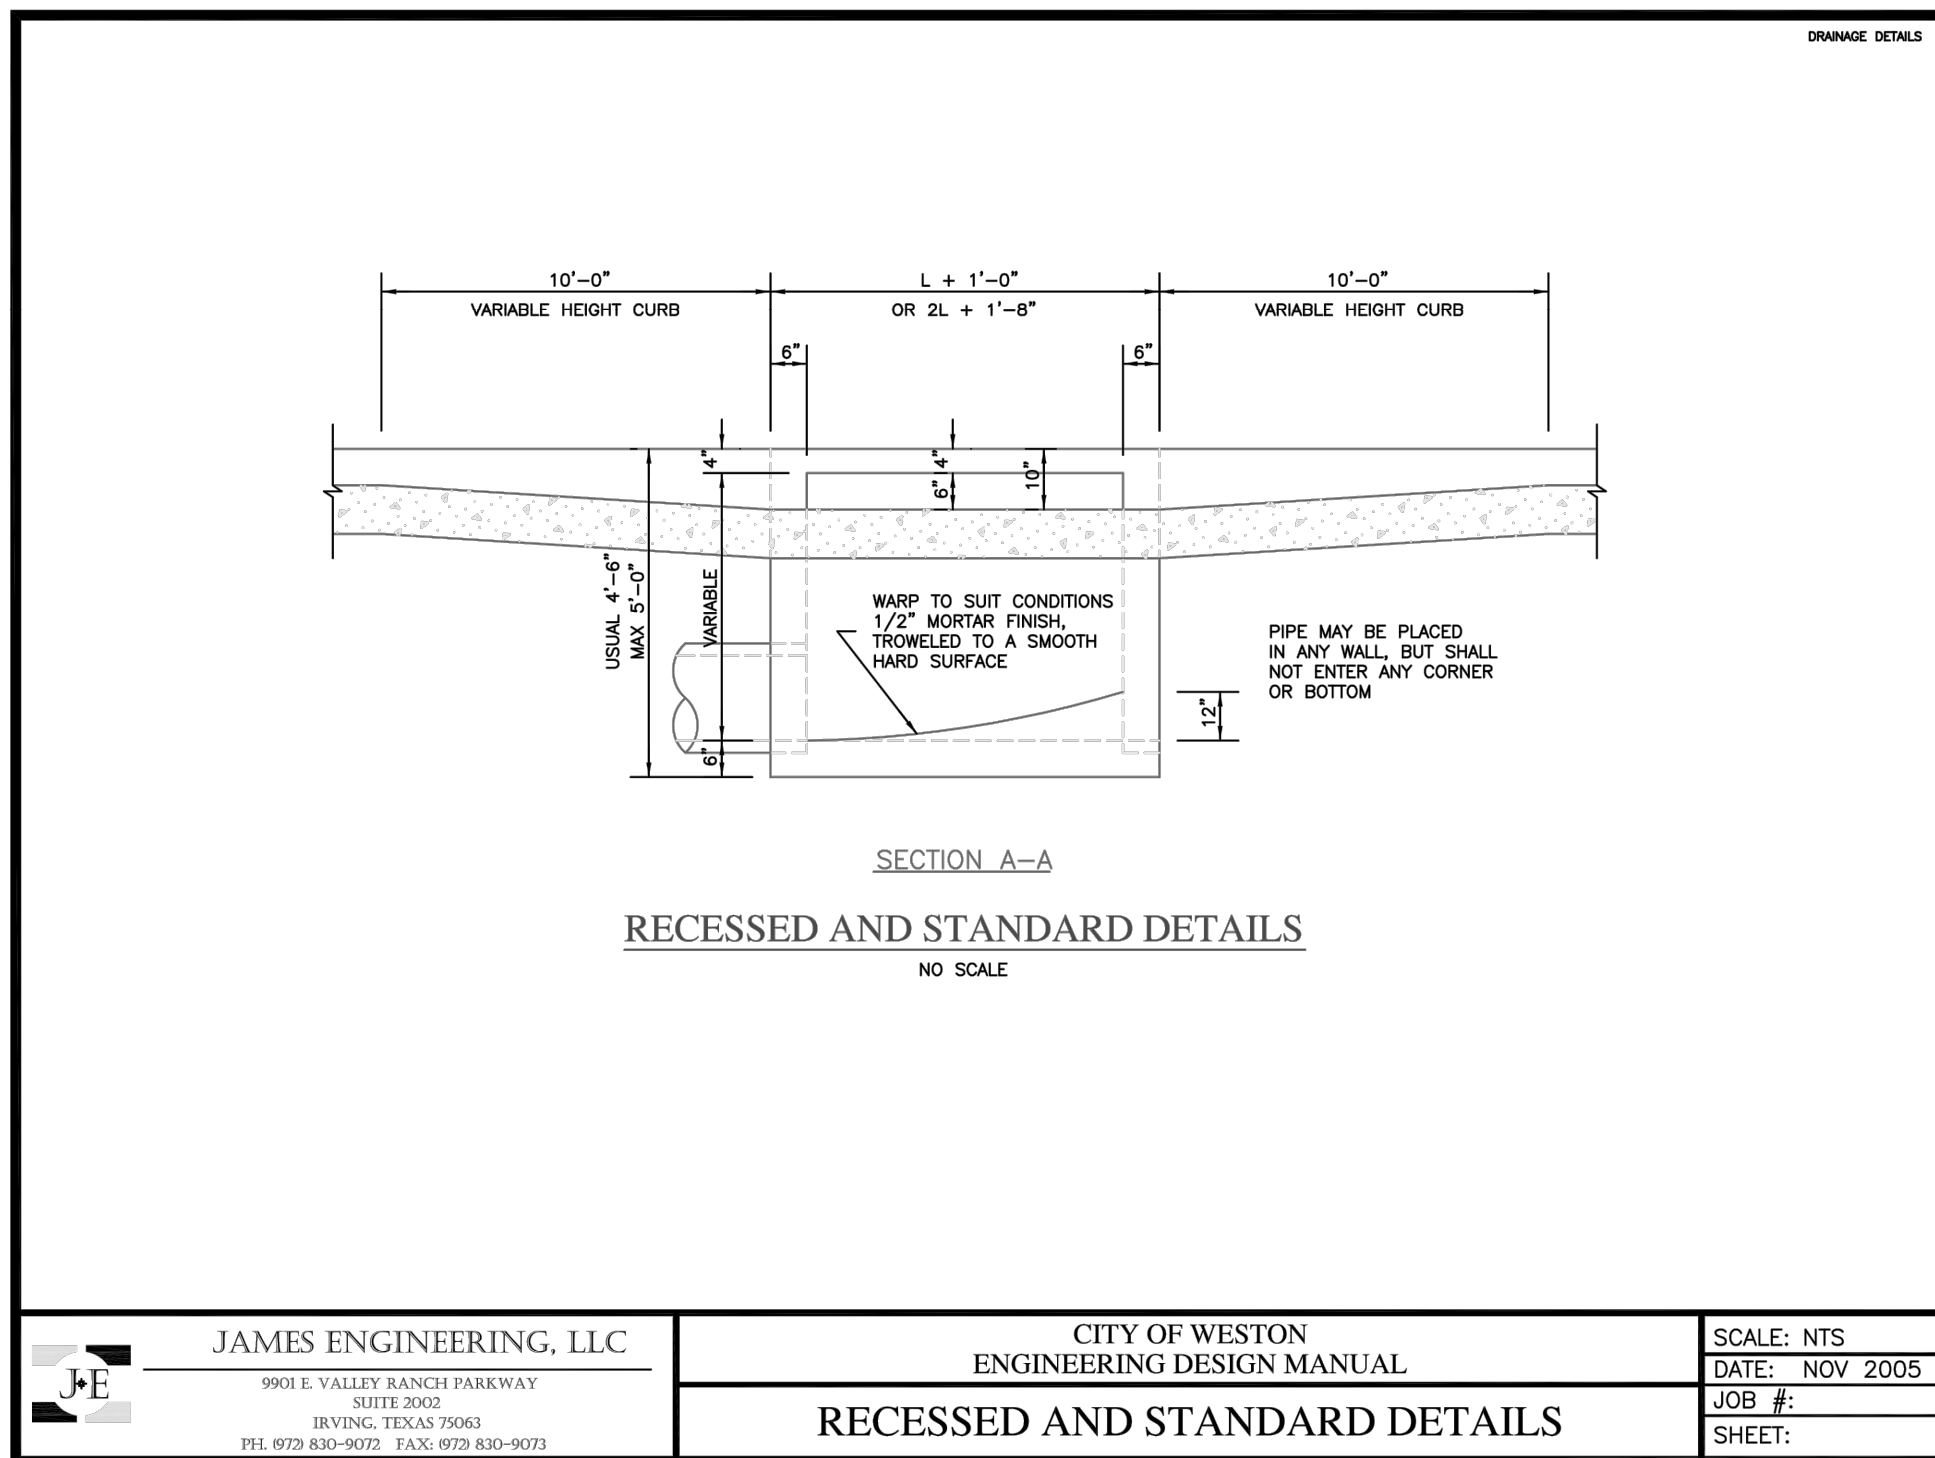










DISCLAIMER:  
The use of this standard is governed by the "Texas Engineering Practice Act". No warranty of any kind is made by JMC or any person, firm, or corporation for any damages, including consequential damages, resulting from its use.

DATE:  
FILE:

TABLE OF VARIABLE DIMENSIONS AND QUANTITIES FOR ONE HEADWALL ④							
SLOPE	DIA OF PIPE, D	Values for one Pipe			Values to be added for each add'l Pipe		
		W	Reinf (Lbs)	Conc (CY) ①	W	Reinf (Lbs)	Conc (CY) ①
2:1	12"	9'- 0"	122	1.1	1'- 9"	15	0.2
	15"	10'- 3"	136	1.3	2'- 2"	16	0.2
	18"	11'- 6"	163	1.5	2'- 8"	19	0.3
	21"	12'- 9"	200	1.8	3'- 1"	31	0.4
	24"	14'- 0"	217	2.1	3'- 7"	34	0.4
	27"	15'- 3"	254	2.4	3'-11"	37	0.5
	30"	16'- 6"	272	2.7	4'- 4"	40	0.6
	33"	17'- 9"	314	3.1	4'- 8"	43	0.6
	36"	19'- 0"	371	3.9	5'- 1"	46	0.8
	42"	21'- 6"	442	4.9	5'-10"	52	1.0
	48"	25'- 0"	569	6.4	6'- 7"	59	1.3
	54"	27'- 6"	701	7.5	7'- 6"	82	1.6
	60"	30'- 0"	794	8.8	8'- 3"	90	1.8
	66"	32'- 6"	894	10.2	8'- 9"	96	2.0
72"	35'- 0"	1055	11.7	9'- 4"	103	2.3	
3:1	12"	13'- 0"	175	1.6	1'- 9"	14	0.2
	15"	14'- 9"	193	1.9	2'- 2"	17	0.2
	18"	16'- 6"	228	2.2	2'- 8"	19	0.3
	21"	18'- 3"	299	2.6	3'- 1"	31	0.4
	24"	20'- 0"	323	3.0	3'- 7"	33	0.4
	27"	21'- 9"	371	3.5	3'-11"	37	0.5
	30"	23'- 6"	415	4.0	4'- 4"	40	0.5
	33"	25'- 3"	469	4.6	4'- 8"	43	0.6
	36"	27'- 0"	556	5.7	5'- 1"	46	0.8
	42"	30'- 6"	675	7.1	5'-10"	52	1.0
	48"	35'- 6"	837	9.2	6'- 7"	59	1.3
	54"	39'- 0"	1015	11.0	7'- 6"	84	1.6
	60"	42'- 6"	1171	12.9	8'- 3"	91	1.8
	66"	46'- 0"	1298	14.9	8'- 9"	98	2.0
72"	49'- 6"	1561	17.1	9'- 4"	103	2.3	
4:1	12"	17'- 0"	229	2.0	1'- 9"	15	0.2
	15"	19'- 3"	266	2.4	2'- 2"	17	0.2
	18"	21'- 6"	308	2.9	2'- 8"	19	0.3
	21"	23'- 9"	382	3.5	3'- 1"	31	0.3
	24"	26'- 0"	430	3.9	3'- 7"	34	0.4
	27"	28'- 3"	486	4.7	3'-11"	37	0.5
	30"	30'- 6"	539	5.2	4'- 4"	40	0.6
	33"	32'- 9"	603	6.0	4'- 8"	42	0.6
	36"	35'- 0"	738	7.5	5'- 1"	47	0.8
	42"	39'- 6"	881	9.3	5'-10"	52	1.0
	48"	46'- 0"	1102	12.1	6'- 7"	61	1.3
	54"	50'- 6"	1364	14.4	7'- 6"	84	1.6
	60"	55'- 0"	1547	16.9	8'- 3"	91	1.8
	66"	59'- 6"	1741	19.5	8'- 9"	98	2.0
72"	64'- 0"	2069	22.4	9'- 4"	102	2.3	
6:1	12"	25'- 0"	336	3.0	1'- 9"	14	0.2
	15"	28'- 3"	384	3.6	2'- 2"	17	0.2
	18"	31'- 6"	452	4.2	2'- 8"	19	0.3
	21"	34'- 9"	581	5.1	3'- 1"	31	0.4
	24"	38'- 0"	644	5.8	3'- 7"	34	0.4
	27"	41'- 3"	737	6.9	3'-11"	37	0.5
	30"	44'- 6"	807	7.7	4'- 4"	39	0.6
	33"	47'- 9"	912	8.9	4'- 8"	44	0.6
	36"	51'- 0"	1108	11.0	5'- 1"	48	0.8
	42"	57'- 6"	1318	13.7	5'-10"	54	1.0
	48"	67'- 0"	1674	17.9	6'- 7"	59	1.3
	54"	73'- 6"	2064	21.3	7'- 6"	83	1.6
	60"	80'- 0"	2343	24.9	8'- 3"	89	1.8
	66"	86'- 6"	2635	28.9	8'- 9"	96	2.0
72"	93'- 0"	3123	33.1	9'- 4"	101	2.3	


- ① Quantities shown are for concrete pipe and will increase slightly for metal pipe installations.
- ② Indicated slope is perpendicular to centerline Pipe or Pipes.
- ③ For vehicle safety, curbs shall project no more than 3" above finished grade. Curb heights shall be reduced, if necessary, to meet these requirements. No changes will be made in quantities and no additional compensation will be allowed for this work.
- ④ Quantities shown are for one structure end only (one headwall).

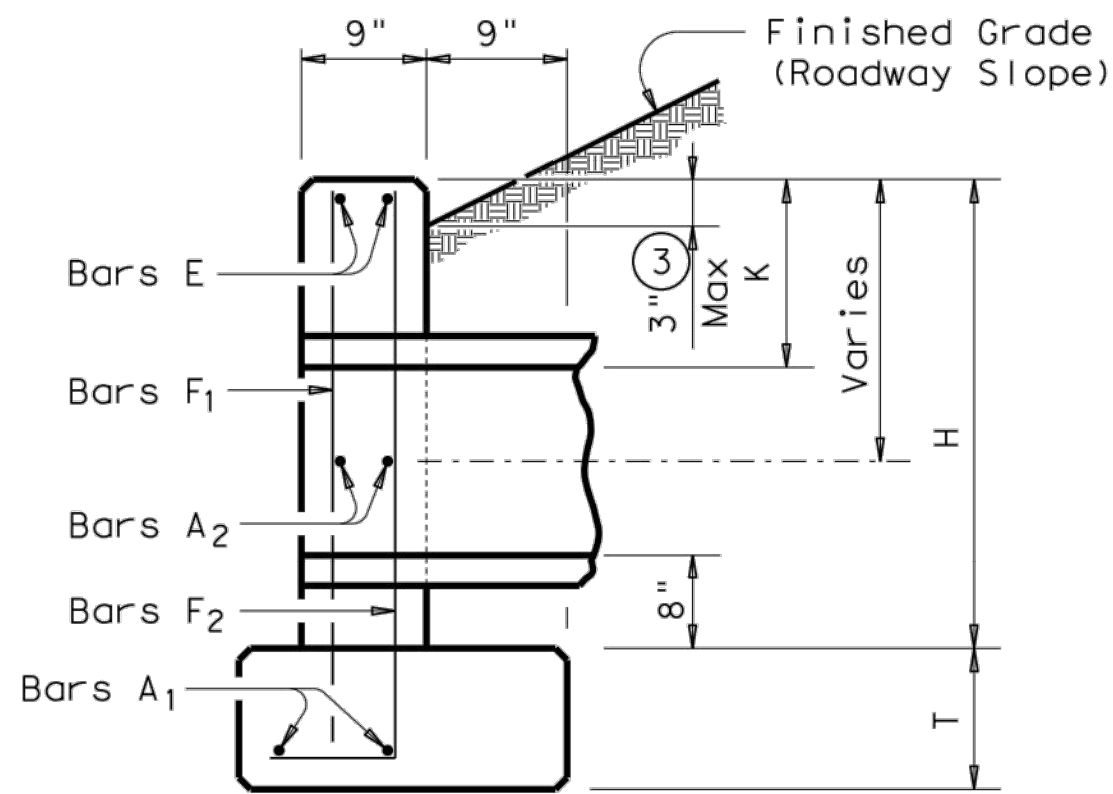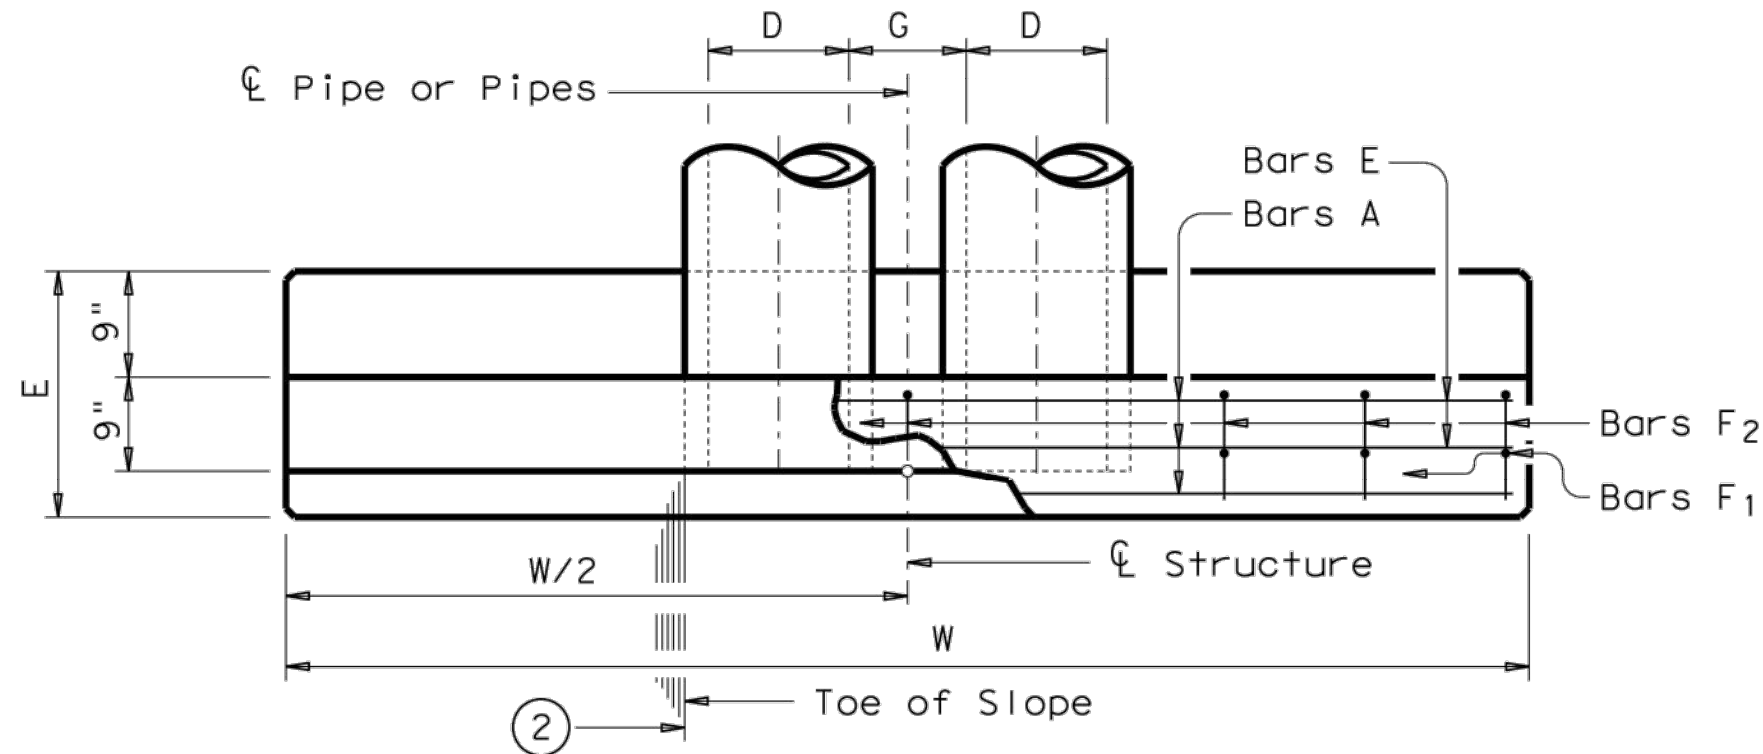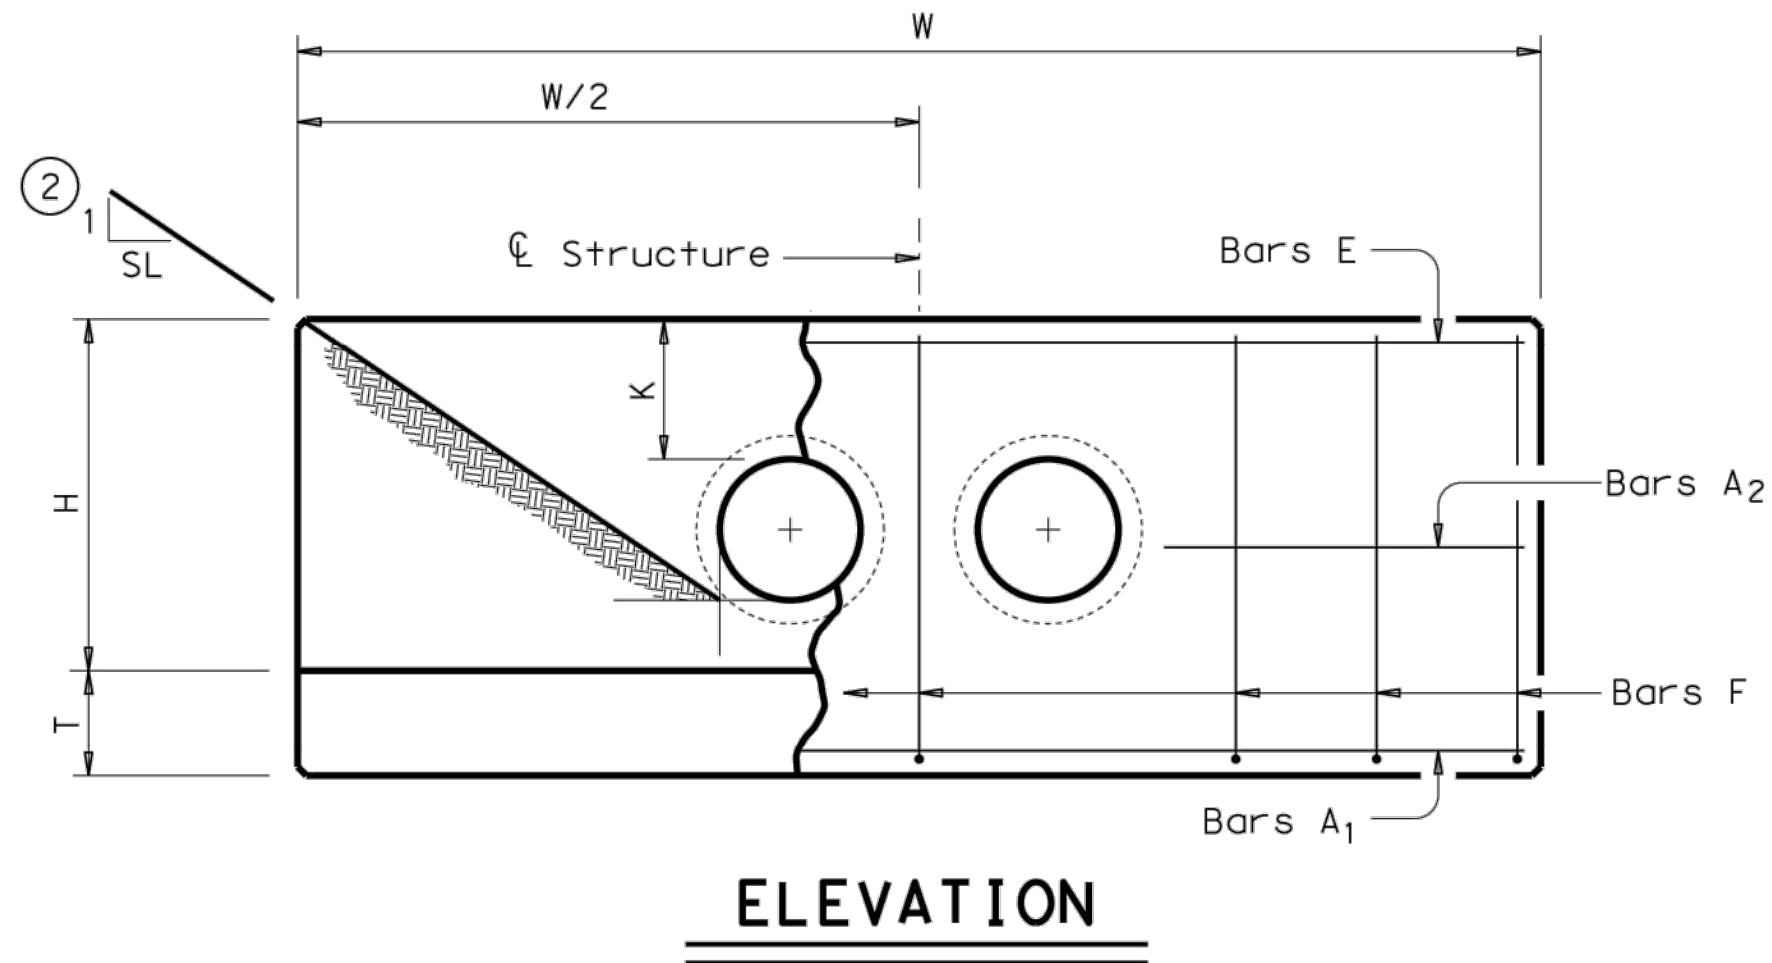

SECTION

TABLE OF CONSTANT DIMENSIONS					
DIA OF PIPE, D	G	K	H	T	E
12"	9"	1'-0"	2'-8"	9"	1'-9"
15"	11"	1'-0"	2'-11"	9"	1'-9"
18"	1'-2"	1'-0"	3'-2"	9"	1'-9"
21"	1'-4"	1'-0"	3'-5"	9"	2'-0"
24"	1'-7"	1'-0"	3'-8"	9"	2'-0"
27"	1'-8"	1'-0"	3'-11"	9"	2'-3"
30"	1'-10"	1'-0"	4'-2"	9"	2'-3"
33"	1'-11"	1'-0"	4'-5"	9"	2'-6"
36"	2'-1"	1'-0"	4'-8"	1'-0"	2'-6"
42"	2'-4"	1'-0"	5'-2"	1'-0"	2'-9"
48"	2'-7"	1'-3"	5'-11"	1'-0"	3'-0"
54"	3'-0"	1'-3"	6'-5"	1'-0"	3'-3"
60"	3'-3"	1'-3"	6'-11"	1'-0"	3'-6"
66"	3'-3"	1'-3"	7'-5"	1'-0"	3'-9"
72"	3'-4"	1'-3"	7'-11"	1'-0"	4'-0"

TABLE OF REINFORCING STEEL <sup>④</sup>			
Bar	Size	Spa	No.
A1	# 5	~	2
A2	# 5	1'-6"	~
E	# 5	~	2
F	# 5	1'-0"	~

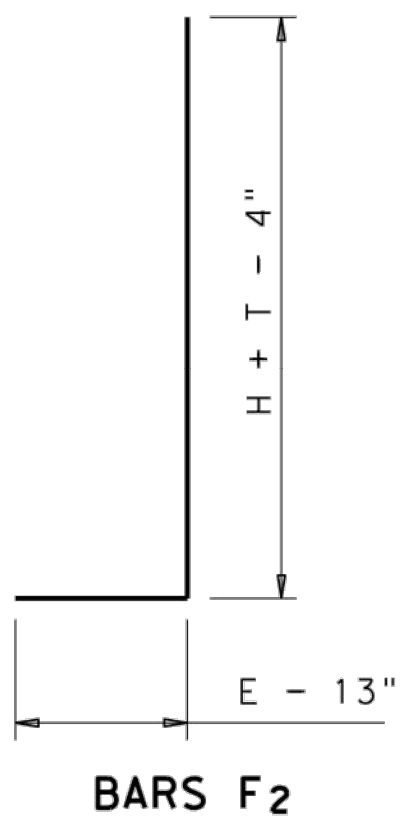

**GENERAL NOTES:**  
Designed according to AASHTO LRFD Specifications.  
Reinforcing steel shall be placed with the center of the outside layer of bars 2" from the surface of the concrete.  
All reinforcing steel shall be Grade 60.  
All concrete shall be Class "C" and shall have a minimum compressive strength of 3600 psi.  
No bridge rails of any type may be mounted directly to these culvert headwalls.

		Bridge Division Standard			
<b>CONCRETE HEADWALLS WITH PARALLEL WINGS FOR NON-SKEWED PIPE CULVERTS</b>					
<b>CH-PW-0</b>					
FILE: chpw0ste.dgn	DN: TxDOT	CK: TxDOT	DW: TxDOT		
©TxDOT February 2010	CONT	SECT	JOB		
REVISIONS		HIGHWAY			
DIST		COUNTY			
		SHEET NO.			

AS BUILT  
10/29/2019

THIS RECORD DRAWING IS A COMPILATION OF SEALED ENGINEERING DRAWINGS FOR THIS PROJECT MODIFIED BY INFORMATION FURNISHED BY THE CONTRACTOR, BASED ON THE CONTRACTORS' INFORMATION AND GENERAL INSPECTION BY THE CITY.

NAME	TWA	DESCRIPTION	AS BUILT	DATE	10/29/19	PROJECT NO.	JM-RRY001.0	DRAWN BY:	TWA	CHECKED BY:	AS	ISSUE DATE:	10/29/19
TXDOT DETAILS													




DISCLAIMER:  
The use of this standard is governed by the "Texas Engineering Practice Act". No warranty of any kind is made by TxDOT for any purpose whatsoever. TxDOT assumes no responsibility for the conversion of this standard to other formats or for incorrect results or damages resulting from its use.

DATE:  
FILE:


TABLE OF VARIABLE DIMENSIONS  
AND QUANTITIES FOR ONE HEADWALL ④

SLOPE	DIA OF PIPE, D	15 Degrees						30 Degrees						45 Degrees					
		Values for one Pipe			Values to be added for each add'l Pipe			Values for one Pipe			Values to be added for each add'l Pipe			Values for one Pipe			Values to be added for each add'l Pipe		
		W	Reinf (Lbs)	Conc (CY) ①	W	Reinf (Lbs)	Conc (CY) ①	W	Reinf (Lbs)	Conc (CY) ①	W	Reinf (Lbs)	Conc (CY) ①	W	Reinf (Lbs)	Conc (CY) ①	W	Reinf (Lbs)	Conc (CY) ①
2:1	12"	9'- 4"	124	1.1	1'- 9 3/4"	15	0.2	10'- 5"	130	1.2	2'- 0"	16	0.2	12'- 9"	159	1.5	2'- 5 3/4"	17	0.3
	15"	10'- 7"	136	1.3	2'- 3"	17	0.2	11'- 10"	159	1.5	2'- 6"	18	0.2	14'- 6"	191	1.8	3'- 0 3/4"	20	0.3
	18"	11'- 11"	165	1.5	2'- 9"	19	0.3	13'- 3"	174	1.7	3'- 1"	29	0.3	16'- 3"	207	2.1	3'- 9 1/4"	33	0.4
	21"	13'- 2"	203	1.9	3'- 2 1/4"	31	0.4	14'- 9"	233	2.1	3'- 6 3/4"	33	0.4	18'- 0"	276	2.6	4'- 4 1/4"	36	0.5
	24"	14'- 6"	240	2.1	3'- 8 1/4"	34	0.4	16'- 2"	251	2.4	4'- 1 3/4"	36	0.5	19'- 10"	318	2.9	5'- 0 3/4"	39	0.6
	27"	15'- 9"	258	2.5	4'- 0 3/4"	38	0.5	17'- 7"	292	2.8	4'- 6 1/4"	39	0.6	21'- 7"	342	3.4	5'- 6 1/4"	44	0.7
	30"	17'- 1"	297	2.8	4'- 5 3/4"	40	0.6	19'- 1"	311	3.1	5'- 0"	42	0.6	23'- 4"	388	3.8	6'- 1 3/4"	47	0.8
	33"	18'- 5"	320	3.3	4'- 9 3/4"	43	0.6	20'- 6"	358	3.6	5'- 4 3/4"	46	0.7	25'- 1"	439	4.4	6'- 7 1/4"	51	0.9
	36"	19'- 8"	401	4.0	5'- 3"	47	0.9	21'- 11"	422	4.5	5'- 10 3/4"	50	0.9	26'- 10"	517	5.5	7'- 2 1/4"	55	1.2
	42"	22'- 3"	476	5.0	6'- 0 3/4"	53	1.1	24'- 10"	528	5.6	6'- 8 3/4"	56	1.2	30'- 5"	634	6.9	8'- 3"	76	1.4
	48"	25'- 11"	577	6.6	6'- 9 3/4"	60	1.3	28'- 10"	637	7.3	7'- 7 1/4"	79	1.5	35'- 4"	791	9.0	9'- 3 3/4"	88	1.8
	54"	28'- 6"	711	7.8	7'- 9"	83	1.6	31'- 9"	781	8.7	8'- 8"	87	1.8	38'- 11"	958	10.7	10'- 7 1/4"	97	2.2
	60"	31'- 1"	805	9.2	8'- 6 1/4"	91	1.9	34'- 8"	881	10.2	9'- 6 1/4"	97	2.1	42'- 5"	1113	12.5	11'- 8"	124	2.6
	66"	33'- 8"	907	10.6	9'- 0 3/4"	98	2.1	37'- 6"	1028	11.8	10'- 1 1/4"	102	2.4	46'- 0"	1235	14.5	12'- 4 1/4"	132	2.9
	72"	36'- 3"	1071	12.1	9'- 8"	105	2.4	40'- 5"	1207	13.5	10'- 9 1/4"	110	2.6	49'- 6"	1446	16.6	13'- 2 1/4"	141	3.2
3:1	12"	13'- 6"	178	1.6	1'- 9 3/4"	15	0.2	15'- 0"	189	1.8	2'- 0"	15	0.2	18'- 5"	237	2.2	2'- 5 3/4"	17	0.2
	15"	15'- 3"	212	1.9	2'- 3"	17	0.2	17'- 0"	223	2.1	2'- 6"	17	0.3	20'- 10"	276	2.6	3'- 0 3/4"	20	0.3
	18"	17'- 1"	231	2.3	2'- 9"	19	0.3	19'- 1"	259	2.5	3'- 1"	29	0.3	23'- 4"	318	3.1	3'- 9 1/4"	32	0.4
	21"	18'- 11"	306	2.7	3'- 2 1/4"	31	0.4	21'- 1"	339	3.0	3'- 6 3/4"	33	0.4	25'- 10"	413	3.7	4'- 4 1/4"	36	0.5
	24"	20'- 8"	345	3.1	3'- 8 1/4"	35	0.4	23'- 1"	384	3.5	4'- 1 3/4"	36	0.5	28'- 3"	462	4.2	5'- 0 3/4"	40	0.6
	27"	22'- 6"	376	3.7	4'- 0 3/4"	38	0.5	25'- 1"	438	4.1	4'- 6 1/4"	39	0.6	30'- 9"	522	5.0	5'- 6 1/4"	44	0.7
	30"	24'- 4"	422	4.1	4'- 5 3/4"	40	0.6	27'- 2"	466	4.6	5'- 0"	42	0.6	33'- 3"	578	5.6	6'- 1 3/4"	47	0.8
	33"	26'- 2"	476	4.8	4'- 10"	43	0.6	29'- 2"	522	5.3	5'- 4 3/4"	46	0.7	35'- 9"	644	6.5	6'- 7 1/4"	51	0.9
	36"	27'- 11"	590	5.9	5'- 3 1/4"	47	0.8	31'- 2"	645	6.6	5'- 10 3/4"	50	0.9	38'- 2"	787	8.0	7'- 2 1/4"	56	1.2
	42"	31'- 7"	684	7.3	6'- 0 1/4"	53	1.1	35'- 3"	776	8.2	6'- 8 3/4"	56	1.2	43'- 2"	933	10.0	8'- 3"	79	1.4
	48"	36'- 9"	880	9.6	6'- 9 3/4"	61	1.3	41'- 0"	953	10.7	7'- 7 1/4"	81	1.5	50'- 2"	1166	13.1	9'- 3 3/4"	88	1.8
	54"	40'- 5"	1065	11.4	7'- 9"	85	1.6	45'- 0"	1185	12.7	8'- 8"	89	1.8	55'- 2"	1435	15.5	10'- 7 1/4"	97	2.2
	60"	44'- 0"	1224	13.3	8'- 6 1/4"	93	1.9	49'- 1"	1356	14.8	9'- 6 1/4"	96	2.1	60'- 1"	1627	18.2	11'- 8"	124	2.6
	66"	47'- 7"	1357	15.4	9'- 1"	98	2.1	53'- 1"	1497	17.2	10'- 1 1/4"	103	2.3	65'- 1"	1834	21.1	12'- 4 1/4"	130	2.9
	72"	51'- 3"	1624	17.7	9'- 8"	105	2.3	57'- 2"	1787	19.7	10'- 9 1/4"	109	2.6	70'- 0"	2210	24.1	13'- 2 1/4"	139	3.2
4:1	12"	17'- 7"	232	2.1	1'- 9 3/4"	15	0.2	19'- 8"	259	2.4	2'- 0"	16	0.2	24'- 0"	314	2.9	2'- 5 3/4"	18	0.2
	15"	19'- 11"	272	2.5	2'- 3"	17	0.2	22'- 3"	301	2.8	2'- 6"	18	0.3	27'- 3"	361	3.5	3'- 0 3/4"	21	0.3
	18"	22'- 3"	313	3.0	2'- 9"	19	0.3	24'- 10"	344	3.3	3'- 1"	29	0.3	30'- 5"	427	4.0	3'- 9 1/4"	32	0.4
	21"	24'- 7"	407	3.6	3'- 2 1/4"	31	0.4	27'- 5"	446	4.0	3'- 6 3/4"	33	0.4	33'- 7"	549	4.9	4'- 4 1/4"	36	0.5
	24"	26'- 11"	455	4.1	3'- 8 3/4"	35	0.4	30'- 0"	499	4.5	4'- 1 3/4"	36	0.5	36'- 9"	609	5.6	5'- 0 3/4"	40	0.6
	27"	29'- 3"	514	4.8	4'- 0 3/4"	38	0.5	32'- 7"	562	5.4	4'- 6 1/4"	40	0.6	39'- 11"	703	6.6	5'- 6 1/4"	43	0.7
	30"	31'- 7"	568	5.4	4'- 5 3/4"	40	0.6	35'- 3"	620	6.0	5'- 0"	42	0.6	43'- 2"	768	7.4	6'- 1 3/4"	49	0.8
	33"	33'- 11"	634	6.2	4'- 10"	43	0.7	37'- 10"	710	7.0	5'- 4 3/4"	46	0.7	46'- 4"	848	8.5	6'- 7 1/4"	52	0.9
	36"	36'- 3"	776	7.7	5'- 3"	48	0.9	40'- 5"	868	8.6	5'- 10 3/4"	49	0.9	49'- 6"	1058	10.6	7'- 2 1/4"	56	1.1
	42"	40'- 11"	921	9.6	6'- 0 1/4"	53	1.0	45'- 7"	1022	10.7	6'- 8 3/4"	57	1.2	55'- 10"	1262	13.1	8'- 3"	78	1.4
	48"	47'- 7"	1152	12.6	6'- 10"	61	1.3	53'- 1"	1268	14.0	7'- 7 1/4"	80	1.5	65'- 1"	1579	17.2	9'- 3 3/4"	86	1.8
	54"	52'- 3"	1416	14.9	7'- 9 1/4"	86	1.6	58'- 4"	1589	16.6	8'- 8"	89	1.8	71'- 5"	1916	20.4	10'- 7 1/4"	95	2.2
	60"	56'- 11"	1606	17.5	8'- 6 3/4"	92	1.9	63'- 6"	1798	19.5	9'- 6 1/4"	95	2.1	77'- 9"	2184	23.9	11'- 8"	122	2.6
	66"	61'- 7"	1811	20.2	9'- 0 3/4"	97	2.1	68'- 8"	2011	22.5	10'- 1 1/4"	101	2.4	84'- 2"	2464	27.6	12'- 4 1/4"	131	2.9
	72"	66'- 3"	2142	23.2	9'- 8"	104	2.4	73'- 11"	2371	25.9	10'- 9 1/4"	108	2.6	90'- 6"	2929	31.7	13'- 2 1/4"	138	3.2
6:1	12"	25'- 11"	342	3.1	1'- 9 3/4"	15	0.2	28'- 10"	374	3.5	2'- 0"	16	0.2	35'- 4"	456	4.3	2'- 5 3/4"	17	0.2
	15"	29'- 3"	390	3.7	2'- 3"	17	0.2	32'- 7"	442	4.2	2'- 6"	18	0.2	39'- 11"	549	5.1	3'- 0 3/4"	20	0.3
	18"	32'- 7"	459	4.4	2'- 9"	20	0.3	36'- 4"	515	4.9	3'- 1"	29	0.3	44'- 7"	629	6.0	3'- 9 1/4"	33	0.4
	21"	36'- 0"	608	5.3	3'- 2 1/4"	31	0.4	40'- 2"	660	5.9	3'- 6 3/4"	33	0.4	49'- 2"	823	7.2	4'- 4 1/4"	38	0.5
	24"	39'- 4"	672	6.0	3'- 8 3/4"	35	0.4	43'- 11"	748	6.7	4'- 1 3/4"	36	0.5	53'- 9"	920	8.2	5'- 0 3/4"	42	0.6
	27"	42'- 8"	770	7.1	4'- 0 3/4"	38	0.5	47'- 8"	852	8.0	4'- 6 1/4"	41	0.5	58'- 4"	1039	9.7	5'- 6 1/4"	45	0.7
	30"	46'- 1"	839	8.0	4'- 5 3/4"	40	0.6	51'- 5"	949	8.9	5'- 0"	44	0.6	62'- 11"	1154	10.9	6'- 1 3/4"	48	0.8
	33"	49'- 5"	947	9.2	4'- 10"	45	0.7	55'- 2"	1040	10.3	5'- 4 3/4"	48	0.7	67'- 6"	1284	12.6	6'- 7 1/4"	50	0.9
	36"	52'- 10"	1151	11.4	5'- 3"	49	0.8	58'- 11"	1287	12.7	5'- 10 3/4"	51	1.0	72'- 1"	1575	15.6	7'- 2 1/4"	55	1.1
	42"	59'- 6"	1365	14.2	6'- 0 1/4"	55	1.0	66'- 5"	1522	15.8	6'- 8 3/4"	57	1.2	81'- 4"	1867	19.4	8'- 3"	76	1.4
	48"	69'- 4"	1729	18.5	6'- 10"	59	1.3	77'- 4"	1934	20.7	7'- 7 1/4"	79	1.5	94'- 9"	2360	25.3	9'- 3 3/4"	86	1.8
	54"	76'- 1"	2130	22.0	7'- 9 1/4"	83	1.6	84'- 10"	2370	24.6	8'- 8"	87	1.8	103'- 11"	2904	30.1	10'- 7 1/4"	95	2.2
	60"	82'- 10"	2414	25.8	8'- 6 3/4"	90	1.9	92'- 5"	2673	28.8	9'- 6 1/4"	94	2.1	113'- 2"	3286	35.3	11'- 8"	122	2.6
	66"	89'- 7"	2712	29.9	9'- 0 3/4"	96	2.1	99'- 11"	3030	33.3	10'- 1 1/4"	101	2.4	122'- 4"	3689	40.8	12'- 4 1/4"	130	2.9
	72"	96'- 3"	3210	34.2	9'- 8"	102	2.4	107'- 5"	3572	38.2	10'- 9 1/4"	108	2.6	131'- 6"	4364	46.8	13'- 2 1/4"	139	3.2

- ① Quantities shown are for concrete pipe and will increase slightly for metal pipe installations.
- ② Indicated slope is perpendicular to centerline Pipe or Pipes.
- ③ For vehicle safety, curbs shall project no more than 3" above finished grade. Curb heights shall be reduced, if necessary, to meet these requirements. No changes will be made in quantities and no additional compensation will be allowed for this work.
- ④ Quantities shown are for one structure end only (one headwall).

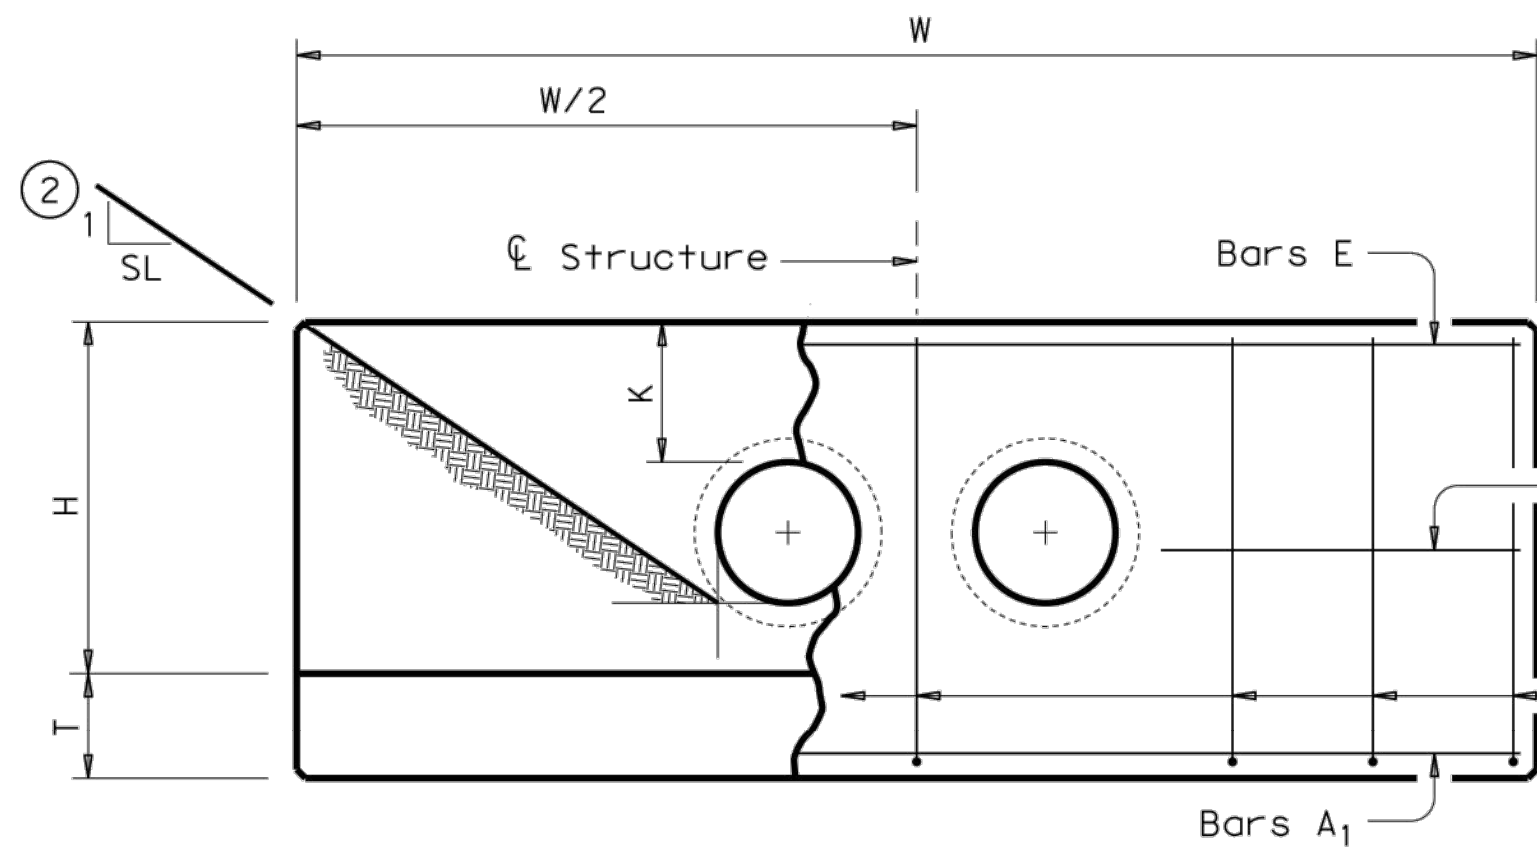

ELEVATION



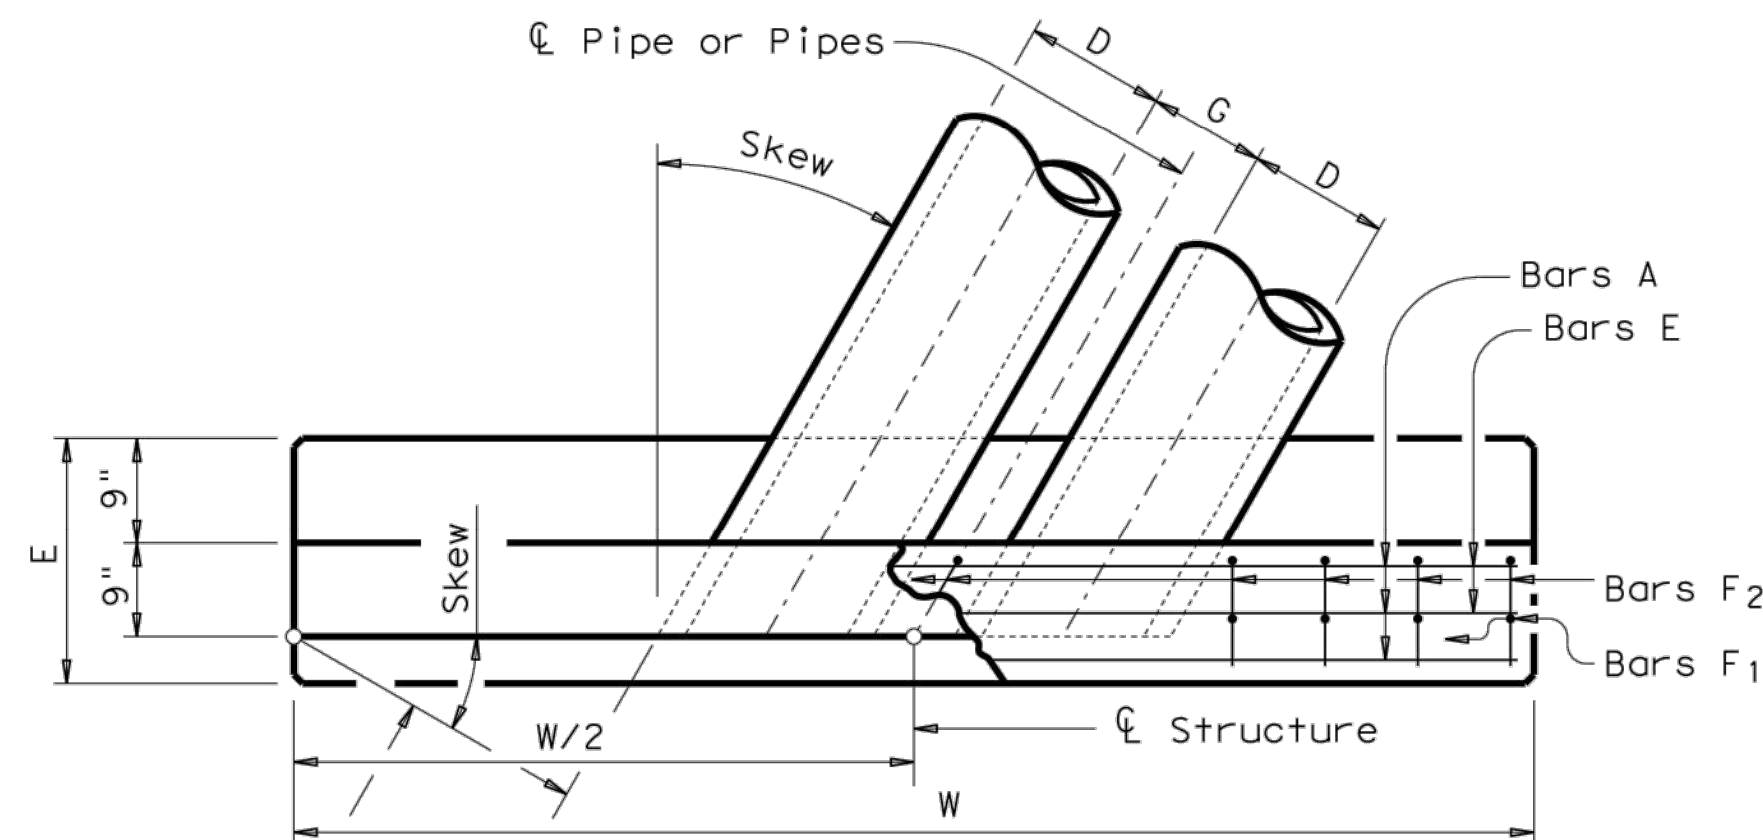










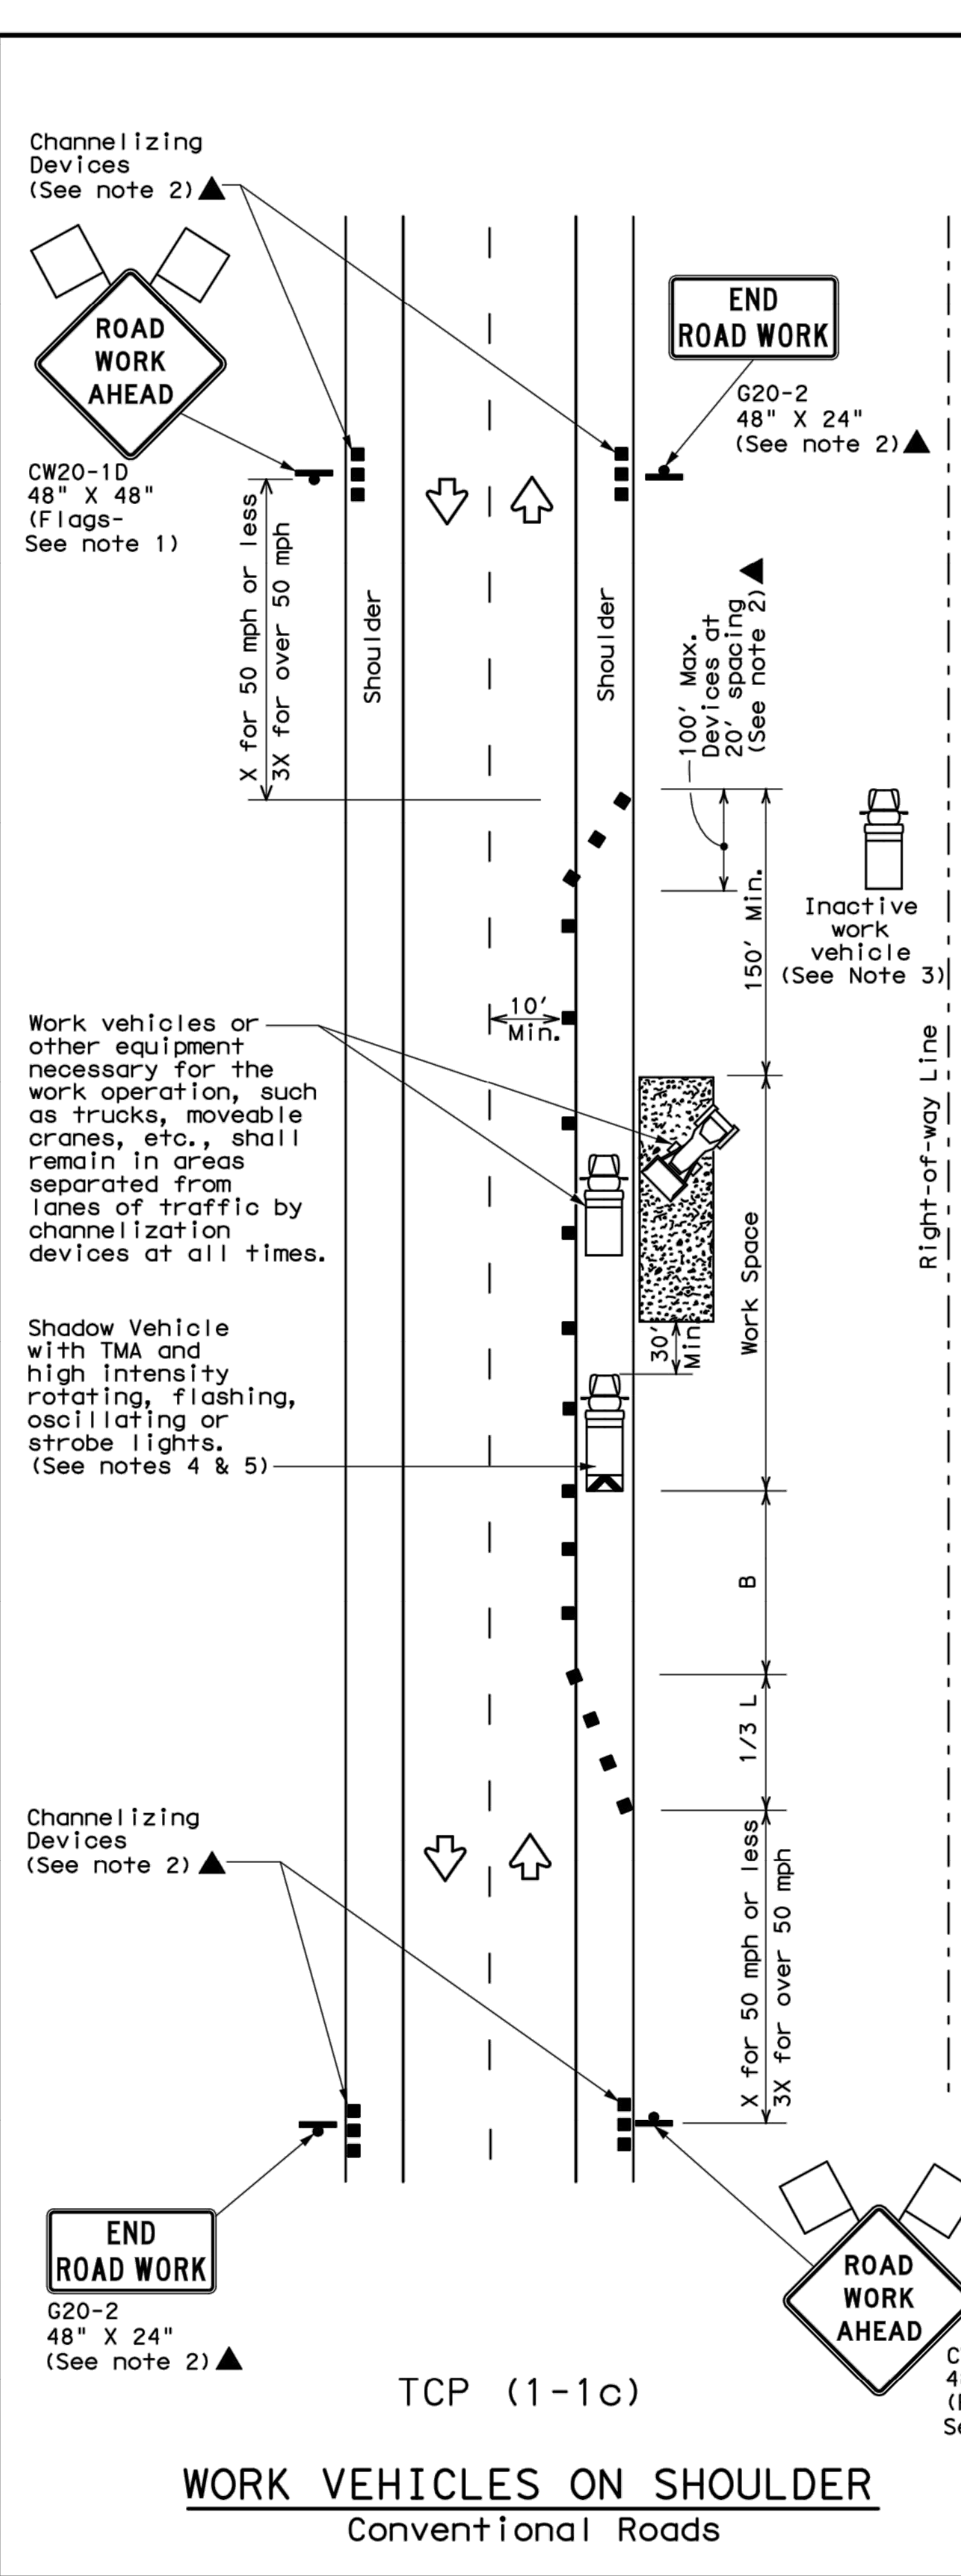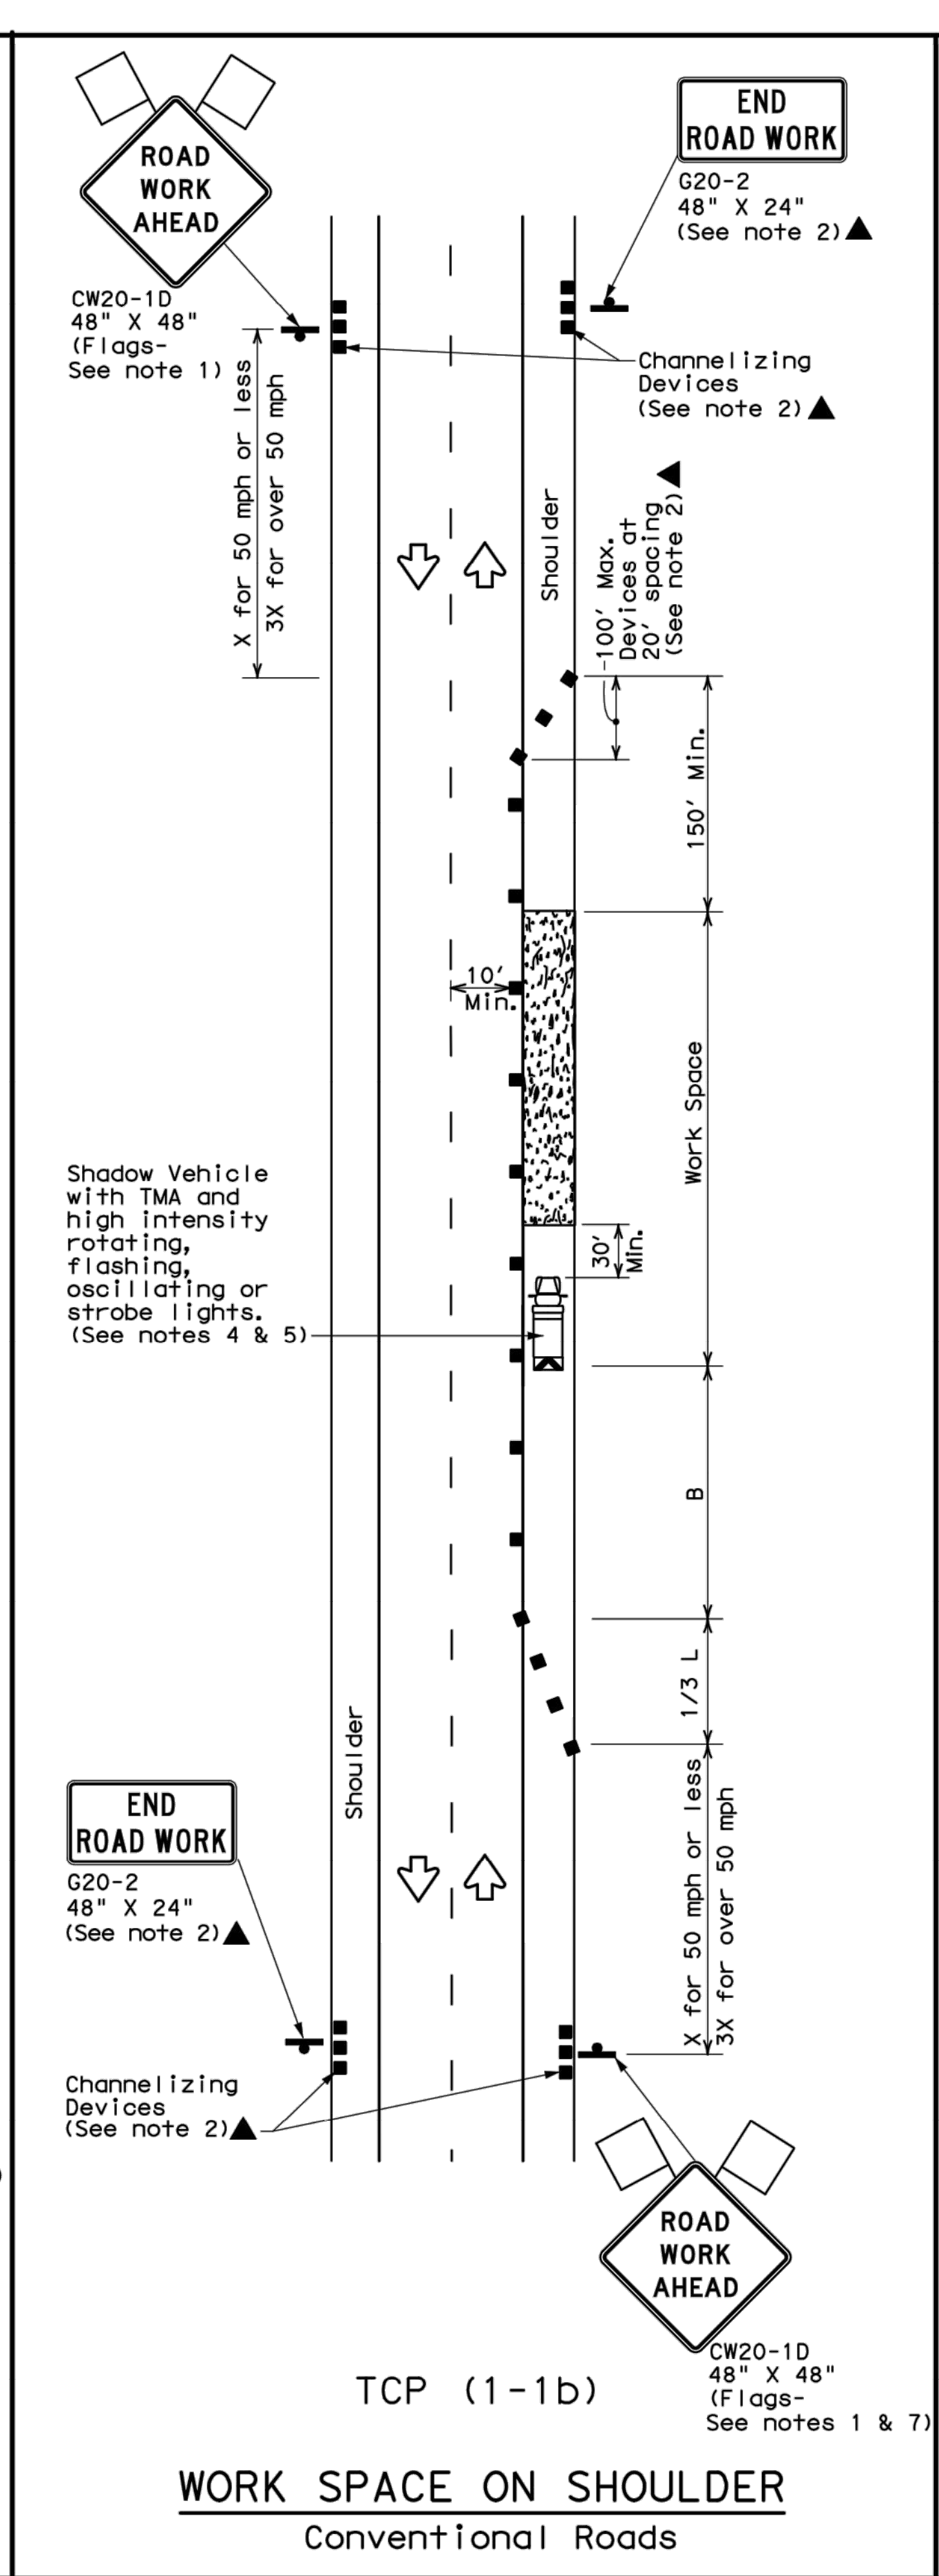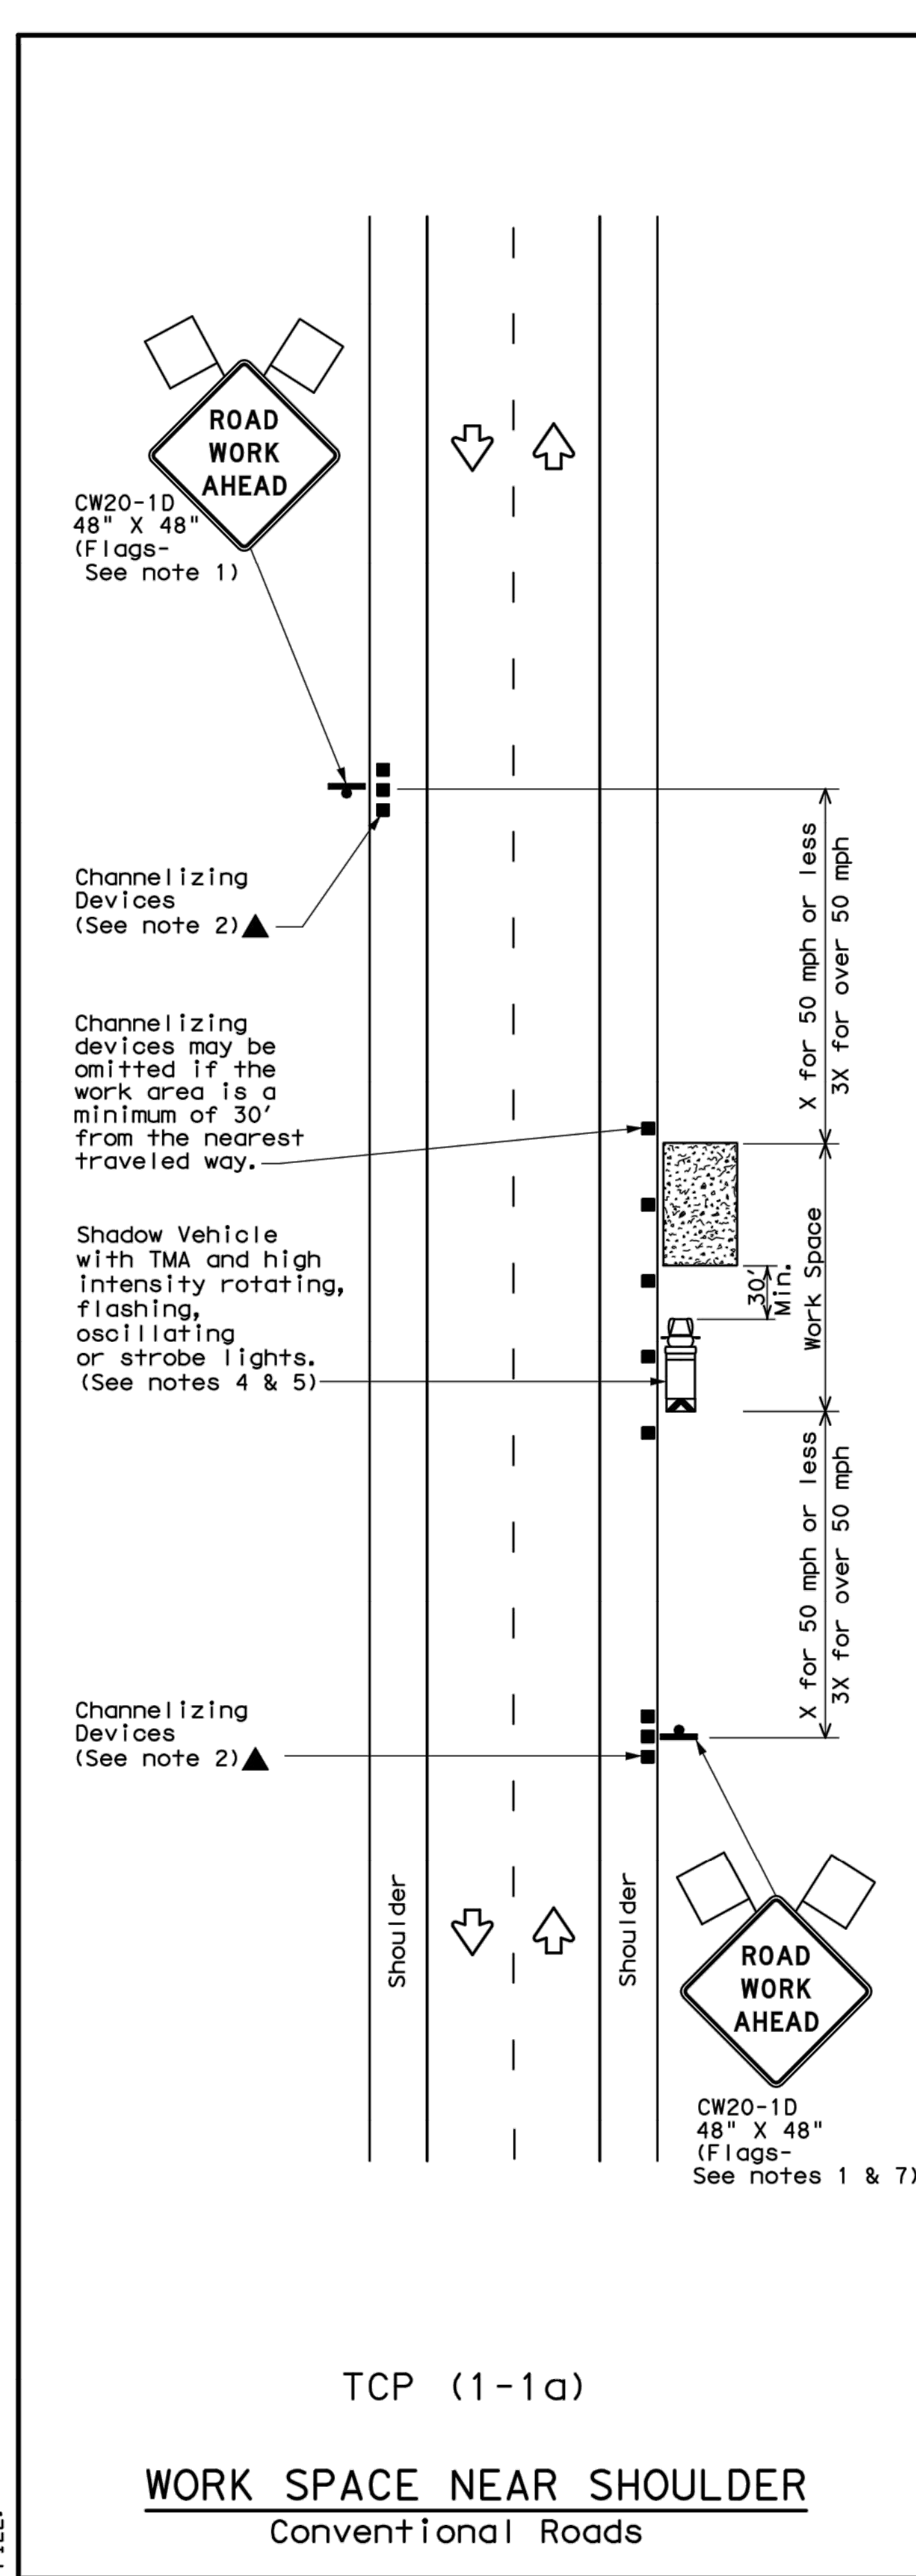

PLAN OF SKEWED PIPES

Showing 30° Sk



**DISCLAIMER:** The use of this standard is governed by the "Texas Engineering Practice Act". No warranty of any kind is made by TxDOT for any purpose whatsoever. TxDOT assumes no responsibility for the conversion of this standard to other formats or for incorrect results or damages resulting from its use.



LEGEND							
	Type 3 Barricade				Channelizing Devices		
	Heavy Work Vehicle				Truck Mounted Attenuator (TMA)		
	Trailer Mounted Flashing Arrow Board				Portable Changeable Message Sign (PCMS)		
	Sign				Traffic Flow		
	Flag				Flagger		

Posted Speed *	Formula	Minimum Desirable Taper Lengths **			Suggested Maximum Spacing of Channelizing Devices		Minimum Sign Spacing "x"	Suggested Longitudinal Buffer Space "B"
		10' Offset	11' Offset	12' Offset	On a Taper	On a Tangent	Distance	
30	$L = \frac{WS^2}{60}$	150'	165'	180'	30'	60'	120'	90'
35		205'	225'	245'	35'	70'	160'	120'
40		265'	295'	320'	40'	80'	240'	155'
45	L=WS	450'	495'	540'	45'	90'	320'	195'
50		500'	550'	600'	50'	100'	400'	240'
55		550'	605'	660'	55'	110'	500'	295'
60		600'	660'	720'	60'	120'	600'	350'
65		650'	715'	780'	65'	130'	700'	410'
70		700'	770'	840'	70'	140'	800'	475'
75		750'	825'	900'	75'	150'	900'	540'

\* Conventional Roads Only

\*\* Taper lengths have been rounded off.

L=Length of Taper (FT) W=Width of Offset (FT) S=Posted Speed (MPH)


TYPICAL USAGE				
MOBILE	SHORT DURATION	SHORT TERM STATIONARY	INTERMEDIATE TERM STATIONARY	LONG TERM STATIONARY
	✓	✓		

### GENERAL NOTES

- Flags attached to signs where shown are REQUIRED.
- All traffic control devices illustrated are REQUIRED, except those denoted with the triangle symbol may be omitted when stated elsewhere in the plans, or for routine maintenance work, when approved by the Engineer.
- Inactive work vehicles or other equipment should be parked near the right-of-way line and not parked on the paved shoulder.
- A Shadow Vehicle with a TMA should be used anytime it can be positioned 30 to 100 feet in advance of the area of crew exposure without adversely affecting the performance or quality of the work. If workers are no longer present but road or work conditions require the traffic control to remain in place, Type 3 Barricades or other channelizing devices may be substituted for the Shadow Vehicle and TMA.
- Additional Shadow Vehicles with TMAs may be positioned off the paved surface, next to those shown in order to protect wider work spaces.
- See TCP(5-1) for shoulder work on divided highways, expressways and freeways.
- CW21-5 "SHOULDER WORK" signs may be used in place of CW20-1D "ROAD WORK AHEAD" signs for shoulder work on conventional roadways.

For construction or maintenance contract work, specific project requirements for shadow vehicles can be found in the project GENERAL NOTES for Item 502, Barricades, Signs and Traffic Handling.



**Texas Department of Transportation**  
Traffic Operations Division

# TRAFFIC CONTROL PLAN

## CONVENTIONAL ROAD

## SHOULDER WORK

# TCP (1-1)-12

(C) TxDOT December 1985 REVISIONS		DN: TXDOT	CK: TXDOT	DW: TXDOT	CK: TXDOT
2-94 1-212 8-95 1-97 4-98	CONT	SECT	JOB		HIGHWAY
	DIST	COUNTY			SHEET NO.

151

## AS BUILT


## 10/29/2019

THIS RECORD DRAWING IS A COMPILATION OF SEALED ENGINEERING DRAWINGS FOR THIS PROJECT MODIFIED BY INFORMATION FURNISHED BY THE CONTRACTOR, BASED ON THE CONTRACTORS' INFORMATION AND GENERAL INSPECTION BY THE CITY.



I:\PRESIDENTIAL LAND\WESTON, TX - 170 & 543\CURRENT DRAWINGS LOT 90\DETAILS LOT 90.DWG 10/29/2019 6:03 PM TIM ANDRIES

DATE: \_\_\_\_\_  
FILE: \_\_\_\_\_

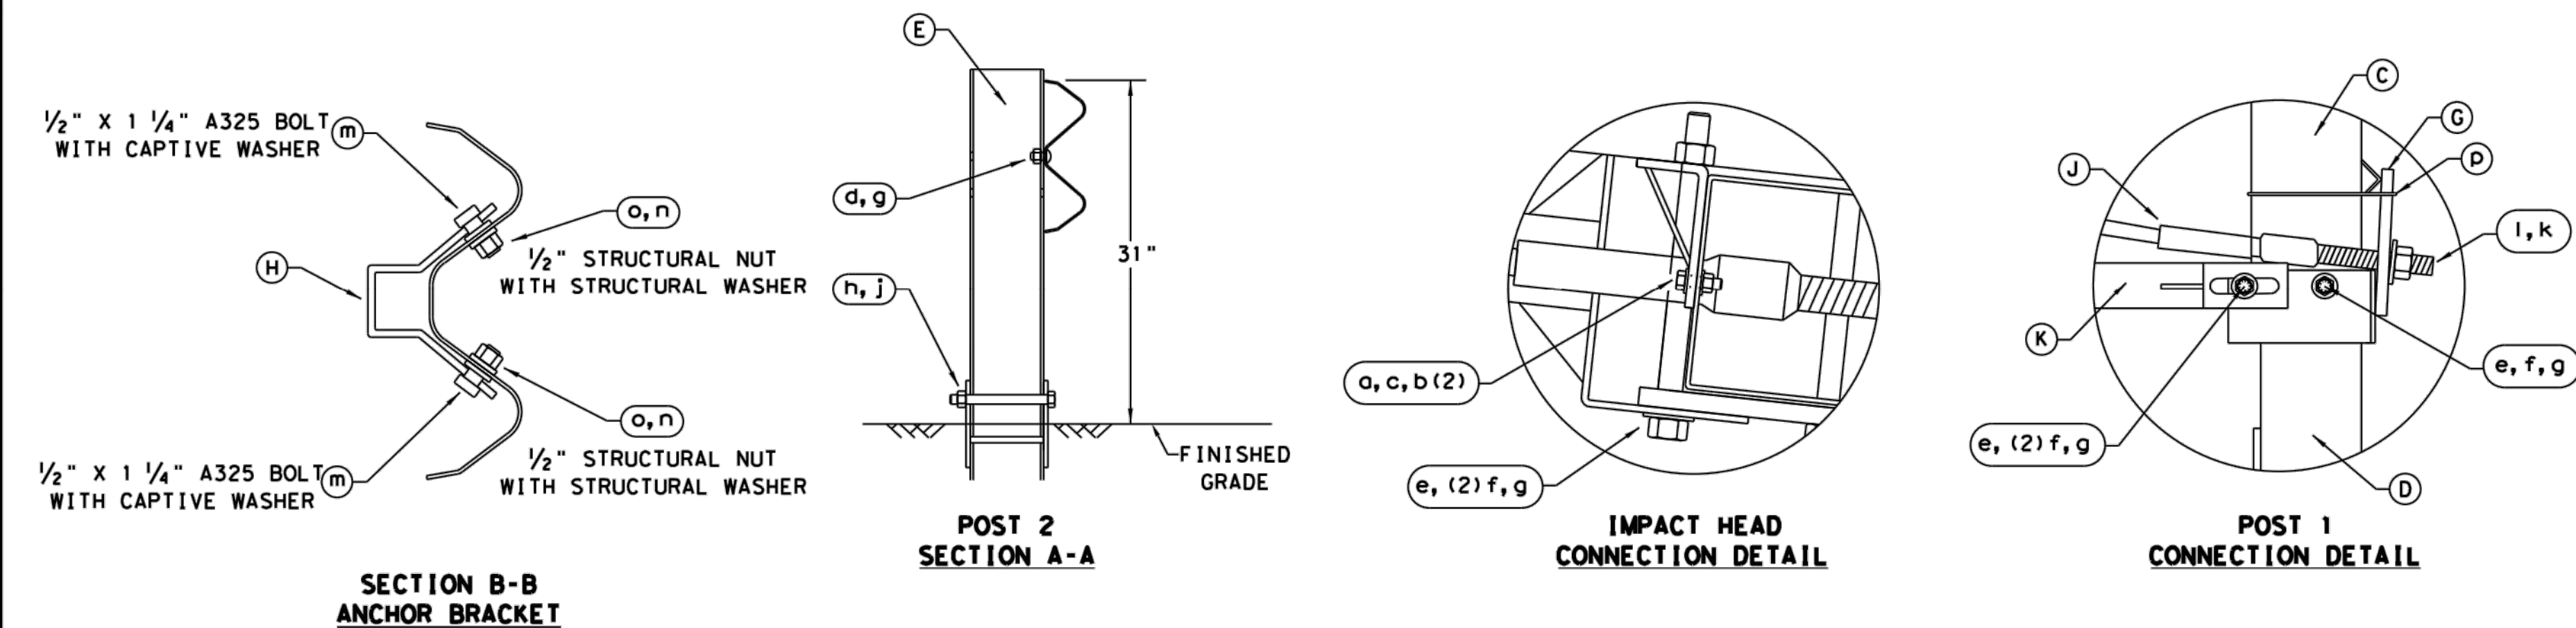

AS BUILT  
10/29/2019

THIS RECORD DRAWING IS A COMPILATION OF SEALED ENGINEERING  
DRAWINGS FOR THIS PROJECT MODIFIED BY INFORMATION FURNISHED  
BY THE CONTRACTOR, BASED ON THE CONTRACTORS' INFORMATION  
AND GENERAL INSPECTION BY THE CITY.

ITEM	QTY	MAIN SYSTEM COMPONENTS	ITEM NUMBERS
A	1	MSKT IMPACT HEAD	MS3000
B	1	W-BEAM GUARDRAIL END SECTION, 12 Gg.	SF1303
C	1	POST 1 - TOP (6" x 6" x 1/8" TUBE)	MTPHP1A
D	1	POST 1 - BOTTOM (6' W6X15)	MTPHP1B
E	1	POST 2 - ASSEMBLY TOP	UHP2A
F	1	POST 2 - ASSEMBLY BOTTOM (6' W6X9)	HP2B
G	1	BEARING PLATE	E750
H	1	CABLE ANCHOR BOX	S760
J	1	BCT CABLE ANCHOR ASSEMBLY	E770
K	1	GROUND STRUT	MS785
L	6	W6x9 OR W6x8.5 STEEL POST	P621
M	6	COMPOSITE BLOCKOUTS	CBSP-14
N	1	W-BEAM MGS RAIL SECTION (9'-4 1/2")	G12025
O	2	W-BEAM MGS RAIL SECTION (12'-6")	G1203A
P	6	WOOD BLOCKOUT 6" x 8" x 14"	P675
Q	1	W-BEAM MGS RAIL SECTION (25'-0")	G1209

SMALL HARDWARE			
a	2	5/8" x 1" HEX BOLT (GRD 5)	B5160104A
b	4	5/8" WASHER	W0516
c	2	5/8" HEX NUT	N0516
d	25	5/8" Dia. x 1 1/4" SPLICE BOLT (POST 2)	B580122
e	2	5/8" Dia. x 9" HEX BOLT (GRD A449)	B580904A
f	3	5/8" WASHER	W050
g	33	5/8" Dia. H.G.R NUT	N050
h	1	3/4" Dia. x 8 1/2" HEX BOLT (GRD A449)	B340854A
j	1	3/4" Dia. HEX NUT	N030
k	2	1" ANCHOR CABLE HEX NUT	N100
l	2	1" ANCHOR CABLE WASHER	W100
m	8	1/2" x 1 1/4" A325 BOLT WITH CAPTIVE WASHER	SB12A
n	8	1/2" STRUCTURAL NUTS	N012A
o	8	1 1/8" O.D. x 3/8" I.D. STRUCTURAL WASHERS	W012A
p	1	BEARING PLATE RETAINER TIE	CT-100ST
q	6	5/8" x 10" H.G.R. BOLT	B581002
r	1	OBJECT MARKER 18" x 18"	E3151



**SINGLE GUARDRAIL TERMINAL**  
**MSKT-MASH-TL-3**  
**SGT (12S) 31-18**

**04/15/19**

NORTHWEST CORNER OF F.M.543 (WESTON ROAD)  
AND C.R.170 WESTON, TX 75097

PROJECT NO: 4-RR18001.0  
DRAWN BY: W/A  
CHECKED BY: S  
ISSUE DATE: 10/29/19

### C9.3